

JAN 19 2000

LIBER 333 PAGE 443

SECTION

LAND CORNER RECORDATION CERTIFICATE
Filing Requirement of Act 74, Mich. P.A. 1970

1356

For corners in

<u>Missaukee County</u>	Located In:	Corner Code #
1. Public Land Survey	T <u>21N</u> R <u>06W</u>	<u>M-12</u>
	T _____ R _____	_____
	T _____ R _____	_____
	T _____ R _____	_____
2. Property Controlling in Section	S _____ T _____ R _____	_____
	S _____ T _____ R _____	_____
3. Miscellaneous Property in Sec.	S _____ T _____ R _____	_____
	S _____ T _____ R _____	_____

MISSAUKEE COUNTY MICHIGAN

RECORDED DEC 09 1999 4⁰⁰ P.M.

Paulyn Flare
REGISTRAR

Register of Deeds Stamp & File Number

4. Lot No. _____, Recorded Plat _____

5. Private Claims _____

I, J. Dean Geers, P.S., in a field survey on June, 19 99 do hereby state that under requirements of P.A. 74, Michigan P.A. of 1970, the corner points mentioned in lines 1 and 2 above were in conformance with regulations and rules therefore as required in the current manual of survey instructions of the United States Department of the Interior, Bureau of Land Management or by a decree of a Court of Law and/or that the corner points mentioned in lines 3, 4 and 5 above were in conformance with the rules of the Michigan Board of Land Surveyors or by a Decree of a Court of Law; established, re-established, monumented, recovered, found as expressed below:

A	B	C	D	E	F	G	H	I	J	K	L	M
1												
2	6		5		4		3		2		1	
3												
4	7		8		9		10		11		12	
5												
6	18		17		16		15		14		13	
7												
8	19		20		21		22		23		24	
9												
10	30		29		28		27		26		25	
11												
12	31		32		33		34		35		36	
13												

NOTE: Not more than 2 corners, all in the same town and range, may be recorded on this certificate.

A. Description of original monument and accessories and/or subsequent restoration:

- M-12) 1837 GLO Quarter Section Post by John Brink, Deputy Surveyor. 8" Cedar-S70W-8 lks, 8" Tamarack-N22W-22 lks.
- M-12) 1938 Schaaf Notes; Found post and USBT stumps. Set monument.
- M-12) 1987 Roser survey and LCRC; Liber 1, Page 751; Found 1 1/2" pipe set by Schaaf from USBT stumps, added Cedar post with location tag. 4" Cedar-N04W-14.1', 6" Cedar-N60W-25.4', 7" Cedar-S76W-23.4', 6" Cedar-S60E-12.7'.

B. Description of corner evidence found and/or method applied in restoring or reestablishing corner:


- M-12) Quarter section corner common to Section 36, T21N, R6W and Section 31, T21N, R5W. Found 1 1/2" pipe and cedar location post as recorded in Liber 1, Page 751. Corner is in cedar swamp. This corner is accepted as a careful and faithful perpetuation of the position of the original corner.

C. Description of monument for corner and accessories established to perpetuate locating the position of the corner:

- M-12) Found 1 1/2" pipe and drove 5/8" x 36" rebar into pipe and set Missaukee County Monument.

- *N56W 25.39' Set nail in north face 7" cedar
- *S51E 13.24' Set nail in northeast face 7" cedar
- *North 14.43' Set nail in east face 6" cedar
- *S81W 23.72' Set nail in south face 9" cedar
- N35W ±70' Edge of swamp

*Previous Witness

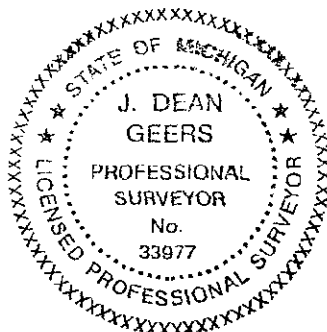

Peer Group Reviewed and Approved

Date: 12-9-99

J. Dean Geers
J. Dean Geers, Missaukee Co. Representative

Signed by *J. Dean Geers*

Date 11-23-99

Surveyor's Michigan License No. 33977