

JAN 19 2000

SECTION

LAND CORNER RECORDATION CERTIFICATE
Filing Requirement of Act 74, Mich. P.A. 1970

LIBER 333 PAGE 415

For corners in

1327

Form with fields for Missaukee (County), Located in, Corner Code #, and survey types (Public Land Survey, Property Controlling in Section, etc.)

MISSAUKEE COUNTY MICHIGAN
RECORDED DEC 09 1999 3:55 P.M.
Register of Deeds Stamp & File REGISTER

4. Lot No. , Recorded Plat
5. Private Claims

I, William E. Sikkema, in a field survey on August 15, 1999 do hereby state that under requirements of P.A. 74, Michigan P.A. of 1970, the corner points mentioned in lines 1 and 2 above were in conformance with regulations and rules therefore as required in the current manual of survey instructions of the United States Department of the Interior, Bureau of Land Management or by a decree of a Court of Law and /or that the corner points mentioned in lines 3, 4 and 5 above were in conformance with the rules of the Michigan Board of Land Surveyors or by a Decree of a Court of Law; established, re-established, monumented, recovered, found as expressed below:

Grid table with columns A-L and rows 1-13, containing numbers 1-36 and a central dot at row 10, column I.

NOTE: Not more than 2 corners, all in the same town and range, may be recorded on this certificate.

A. Description of original monument and accessories and/or subsequent restoration:


I-10, One-quarter Corner common to Sections 27 & 26, T21N, R7W, a post was set in 1856 by Deputy Surveyor, Colman, witnessed by: N41°E - 10" Fir - 5 Links S52°W - 8" W. Pine - 30 Links
The County Surveyor visited this corner in 1894 for a survey in Section 27 and witnessed by: 24" W. Pine Stump - West - 2 Links
Then the corner was visited again in 1910 for a survey in Section 27 and a 4x4 cedar post was set with no witnesses given.
Mark Robison Certificate of Survey in 1995 shows estab. the E-W 1/4 line with no reference being made to the W 1/4 Corner. Per phone call to Mark he set an iron and cap by S.P., witnessed by: N44°E-8.03'-F.P.; N60°E-11.35'-8"x8" F.P.; N10°W-24.20'-42" Maple; S25°E-21.35'-F.P.

B. Description of corner evidence found and/or method applied in restoring or reestablishing corner:

I-10, Found 1/2" Iron with cap #15410 (Delmer Porter) at intersection of old fences North, South and East. Corner appears to have been reset by occupation. Porter Iron also fits 1/8" line fence to the West 1/4 mile South. Also found 1/2" Iron with cap #9433 set by Robison which appears to have been set by Single Proportion and is approximately 6' south and 4' West of Porter's corner. Accepted Porter's position which best fits occupation. This Corner is accepted as the best available evidence of the position of the original corner.

C. Description of monument for corner and accessories established to perpetuate locating the position of the corner:

I-10,
Set Brass Miss. County Remon cap stamped #45505, 1999, on existing iron.
Set nail S Side 10" Maple Clump - West - 69.58'
Set nail SW Side 6"x6" Fence Post - S55°E - 7.93'
Set nail SW Side 38" Maple - N40°W - 19.40'
Fd Iron and Cap #9433 - S32°W - 7.98'

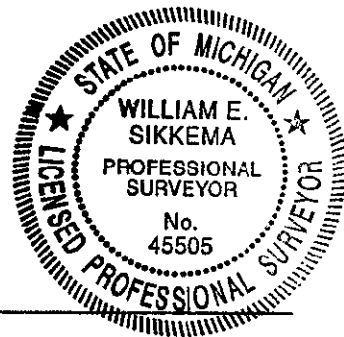

Signed by William E Sikkema
Surveyor's Michigan License No. 45505

Date 11/3/99

Peer Group Reviewed and Approved
Date: 11-8-99
J. Dean Geers, Missaukee Co. Representative