

JAN 19 2000

LIBER 333 PAGE 416

SECTION

LAND CORNER RECORDATION CERTIFICATE
Filing Requirement of Act 74, Mich. P.A. 1970

For corners in

Missaukee Located In: Corner Code #
(County)

1328

- 1. Public Land Survey T 21N R 07W I-11
T _____ R _____
T _____ R _____
T _____ R _____
- 2. Property Controlling in Section S _____ T _____ R _____
S _____ T _____ R _____
- 3. Miscellaneous Property in Sec. S _____ T _____ R _____
S _____ T _____ R _____

MISSAUKEE COUNTY MICHIGAN

RECORDED DEC 09 1999 3:55 P.M.

Paulyn Flare
Register of Deeds Stamp
Number

- 4. Lot No. _____, Recorded Plat _____
- 5. Private Claims _____

I, William E. Sikkema, in a field survey on August 15, 1999 do hereby state that under requirements of P.A. 74, Michigan P.A. of 1970, the corner points mentioned in lines 1 and 2 above were in conformance with regulations and rules therefore as required in the current manual of survey instructions of the United States Department of the Interior, Bureau of Land Management or by a decree of a Court of Law and/or that the corner points mentioned in lines 3, 4 and 5 above were in conformance with the rules of the Michigan Board of Land Surveyors or by a Decree of a Court of Law, established, re-established, monumented, recovered, found as expressed below:

NOTE: Not more than 2 corners, all in the same town and range, may be recorded on this certificate.

	A	B	C	D	E	F	G	H	I	J	K	L	M
1													
2	6			5			4			3			1
3													
4	7			8			9			10			12
5													
6	10			17			16			15			13
7													
8	19			20			21			22			24
9													
10	30			29			28			27			25
11													
12	31			32			33			34			36
13													

A. Description of original monument and accessories and/or subsequent restoration:


I-11, Corner common to Sections 26, 27, 34, and 35, T21N-R7W: Corner was set as a post by Deputy Surveyor Colman in 1856 and witnessed by: N46°E - 14" Hemlock - 13 Links S16°W - 22" W. Pine - 42 Links
Missaukee County Surveyor notes in 1894 of Section 26 uses corner with no witnesses or description given.
Missaukee County Surveyor in 1910 set an 1"x12" Iron Bolt and 2-6"x8" large stones around this corner and witnessed it by:
N3°W - 10" Fence Post - 50 1/2 Links
Missaukee County Surveyor in 1912 found the iron bolt and stones and used the same witness.
Craig Pullen, 1999 Certificate of Survey fd 1 1/4" iron 1' South of Centerline of Meyering Rd, 2.5' East of Centerline of Van Dermullen Road.
Witnessed by: N07°W - Top of T-Ped - 35.14' S44°E - 1/2" Iron - 46.91'
S40°E - P. Pole - 41.33' S66°W - Fence Post - 74.35'

B. Description of corner evidence found and/or method applied in restoring or reestablishing corner:

I-11, Found 1" square headed bolt with stones around, 1' South of Centerline Meyering Rd., 2' East of Centerline Van Dermullen Rd. Found no County Surveyor witnesses, found all witnesses from Pullen Survey. This corner is accepted as the best available evidence of the position of the original corner.

C. Description of monument for corner and accessories established to perpetuate locating the position of the corner:

- I-11
- Set Brass Miss. County Mon. in Mon. Box stamped #45505, 1999, at exact location of bolt
- Set Nail in SW side of Power Pole - S38°E - 41.61'
- Fd Nail N Side Corner Fence Post - S66°W - 74.36'
- Buried Cable Sign - N69°W - 71.00'
- "X" on Top of Tel Box - N07°W - 35.14'
- 1/2" Iron and cap - S44°E - 46.91'

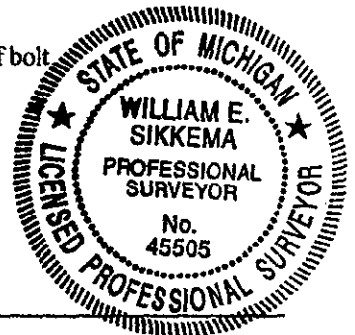

Signed by William E. Sikkema Date 11/03/99

Surveyor's Michigan License No. 45505

Peer Group Reviewed and Approved
Date: 12-9-99
J. Dean Geers
J. Dean Geers, Missaukee Co. Representative