

JAN 13 2000

SECTION

LAND CORNER RECORDATION CERTIFICATE
Filing Requirement of Act 74, Mich. P.A. 1970

LIBER 333 PAGE 419

#1331

For corners in

Missaukee (County)	Located In:	Corner Code #
1. Public Land Survey	T <u>21 N</u> R <u>07 W</u>	<u>J-11</u>
	T _____ R _____	_____
	T _____ R _____	_____
	T _____ R _____	_____
2. Property Controlling in Section	S _____ T _____ R _____	_____
	S _____ T _____ R _____	_____
3. Miscellaneous Property in Sec.	S _____ T _____ R _____	_____
	S _____ T _____ R _____	_____

MISSAUKEE COUNTY MICHIGAN
RECORDED DEC 09 1999 3:55 P.M.
Carolyn Flare
REGISTER
Register of Deeds Stamp & File Number

4. Lot No. _____, Recorded Plat _____
5. Private Claims _____

I, William E. Sikkema, in a field survey on August 15, 1999 do hereby state that under requirements of P.A. 74, Michigan P.A. of 1970, the corner points mentioned in lines 1 and 2 above were in conformance with regulations and rules therefore as required in the current manual of survey instructions of the United States Department of the Interior, Bureau of Land Management or by a decree of a Court of Law and/or that the corner points mentioned in lines 3, 4 and 5 above were in conformance with the rules of the Michigan Board of Land Surveyors or by a Decree of a Court of Law; established, re-established, monumented, recovered, found as expressed below:

	A	B	C	D	E	F	G	H	I	J	K	L	M
1													
2	6			5		4		3		2		1	
3													
4	7			8		9		10		11		12	
5													
6	16			17		16		15		14		13	
7													
8	19			20		21		22		23		24	
9													
10	30			29		28		27		26		25	
11													
12	31			32		33		34		35		36	
13													

NOTE: Not more than 2 corners, all in the same town and range, may be recorded on this certificate.

A. Description of original monument and accessories and/or subsequent restoration:


J-11, One-quarter Corner common to Sections 26 & 35, T21N, R7W, was set as a post in 1856 by Deputy Surveyor, Colman, the corner was set on the West side of stream bed, witnessed by: N35°E - 17" Fir - 43 Links; N27 1/2°W - 14" Elm - 63 Links
County Surveyor visited this corner in 1894 and set a new stake with no witnesses given.
James Granger Certificate of Survey in 1993 in Section 35 shows establishing the N-S 1/4 line from a found center post with no reference made to the North 1/4 corner.
Mark Robison Certificate of Survey in 1995 of the SE 1/4 of the NE 1/4 of Section 26. Gives no witnesses on certificate. Per Phone call to Mark, He found a Bar & Cap witnessed by: North-29.70-Cable Sign; South-6'-CL Road; South-27.0-Gd rail post; S45°E-34.0-Gd rail post .
Craig Pullen Certificate of Survey in 1999 shows finding Bar & Cap #15410 (Del Porter) witnessed by: 7' North of CL Meyering Rd, S49°E - Top of Guard Rail Post - 43.92', S62°E - PK top of Guard Rail Post- 60.38', S11°E- PK in Top of Gaurd Rail Post - 27.22', N11°E - Steel Post-29.66.

B. Description of corner evidence found and/or method applied in restoring or reestablishing corner:

J-11, Found Bar & Cap #15410 from Pullen Survey. Position is 7' North of Centerline Meyering Rd. Position fits approximate Government call of the Stream Bank, and S.P. position between the Section Corners. No other evidence found from old GLO or County Surveyor or any occupation. This corner is accepted as a careful and faithful reestablishment of the position of the original corner.

C. Description of monument for corner and accessories established to perpetuate locating the position of the corner:

J-11
Replaced cap with Miss. County Brass Cap, stamped #45505, 1999. Added Monument by:
Fd PK nail in top of end guard rail post - S03°E - 27.26'
Fd PK nail in guard rail post - S50°E - 44.05'
Buried Cable Sign - N17°E - 29.61'
Fd. PK top of guard rail post - S62°E - 60.38'

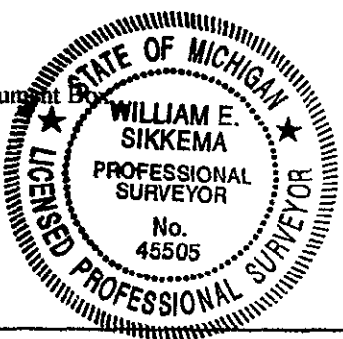

Signed by William E Sikkema Date 8/25/99
Surveyor's Michigan License No. 45505

Peer Group Reviewed and Approved
Date: 12-9-99
J. Dean Geers
J. Dean Geers, Missaukee Co. Representative