

JAN 19 2000

SECTION

LIBER 333 PAGE 420

LAND CORNER RECORDATION CERTIFICATE
Filing Requirement of Act 74, Mich. P.A. 1970

#1332

For corners in

Table with columns: Missaukee (County), Located In, Corner Code #. Rows include Public Land Survey, Property Controlling in Section, and Miscellaneous Property in Sec.

MISSAUKEE COUNTY MICHIGAN

RECORDED DEC 09 1999 3:55 P.M.

Signature of Register: Carolyn Flare


REGISTER

Register of Deeds Stamp & File Number

4. Lot No. , Recorded Plat
5. Private Claims

I, William E. Sikkema, in a field survey on August 15, 1999 do hereby state that under requirements of P.A. 74, Michigan P.A. of 1970, the corner points mentioned in lines 1 and 2 above were in conformance with regulations and rules...

NOTE: Not more than 2 corners, all in the same town and range, may be recorded on this certificate.

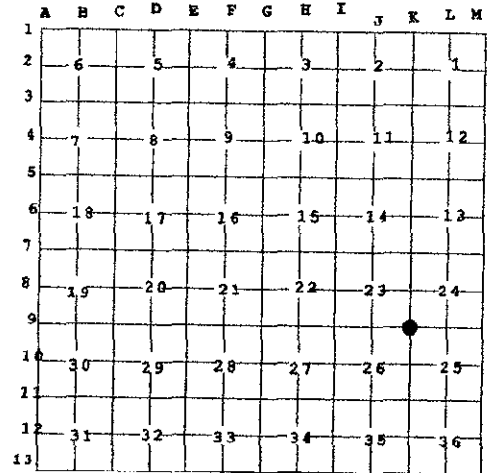

A. Description of original monument and accessories and/or subsequent restoration:

K-9, Section Corner common to Sections 23, 24, 25, & 26, T21N-R7W. Post set by Deputy Surveyor, Colman in July 1856. Corner witnessed by: N16°E - 14" Hemlock - 37 Links S34°W - 18" Hemlock - 11 Links...

B. Description of corner evidence found and/or method applied in restoring or reestablishing corner:


K-9, Found 1/2" Pipe of record 1.5' North of Centerline intersection, no evidence of GLO or County Surveyor corner witnesses. This corner is accepted as the best available evidence of the position of the original Corner.

C. Description of monument for corner and accessories established to perpetuate locating the position of the corner:

K-9
Replace Pipe with 1/2" by 18" rebar with Miss. County Mon., stamped #45505, 1999, in Mon. Box
Fd nail E side light pole - 51.87' - N45°W
Set nail W side power pole - 66.73' - S40°E
Set nail E side power pole - 75.09' - S39°W
SE Edge 3' Tall Stone - 121.90' - N71°W
Telephone Riser - 54.40' - N45°E

Signed by William E. Sikkema
Surveyor's Michigan License No. 45505

Date 11/03/99

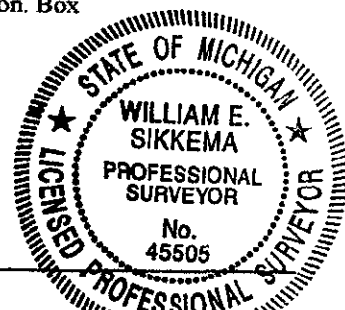

Peer Group Reviewed and Approved

Date: 12-9-99

J. Dean Geers, Missaukee Co. Representative