

JAN 19 2000

LIBER 333 PAGE 421

SECTION

LAND CORNER RECORDATION CERTIFICATE
Filing Requirement of Act 74, Mich. P.A. 1970

1333

For corners in

Missaukee (County)	Located In:	Corner Code #
1. Public Land Survey	T 21 N R 07 W	K-10
	T R	
	T R	
	T R	
2. Property Controlling in Section	S T R	
	S T R	
3. Miscellaneous Property in Sec.	S T R	
	S T R	

MISSAUKEE COUNTY MICHIGAN
RECORDED DEC 09 1999 3:55 PM.
Roslyn Flare
REGISTER
Register of Deeds Stamp & File
Number

4. Lot No. _____, Recorded Plat _____
5. Private Claims _____

I, William E. Sikkema, in a field survey on August 15, 19 99 do hereby state that under requirements of P.A. 74, Michigan P.A. of 1970, the corner points mentioned in lines 1 and 2 above were in conformance with regulations and rules therefore as required in the current manual of survey instructions of the United States Department of the Interior, Bureau of Land Management or by a decree of a Court of Law and /or that the corner points mentioned in lines 3, 4 and 5 above were in conformance with the rules of the Michigan Board of Land Surveyors or by a Decree of a Court of Law; established, re-established, monumented, recovered, found as expressed below:

	A	B	C	D	E	F	G	H	I	J	K	L	M
1													
2	6		5		4		3		2		1		
3													
4	7		8		9		10		11		12		
5													
6	18		17		16		15		14		13		
7													
8	19		20		21		22		23		24		
9													
10	30		29		28		27		26		25		
11													
12	31		32		33		34		35		36		
13													

NOTE: Not more than 2 corners, all in the same town and range, may be recorded on this certificate.

A. Description of original monument and accessories and/or subsequent restoration:


K-10, One quarter Corner common to Sections 26 and 25, T21N, R7W, set post by Deputy Surveyor, Colman and witnessed by: N15°E - 9" Ironwood - 12 Links S39°W - 8" Hemlock - 57 Links
County Surveyor survey of Section 26 in 1894, gives no description of corner, witnessed by: N45°W - 20" Elm Stump - 34 Links
Norman Quaine in 1989 LCRC #881 - Fd no evidence of corner, reset by single proportionate, Fits occupation to West; Witnessed by:
S10°E - Wooden Utility Riser - 114.00' S36°E - 14" Apple - 91.90' N04°W - P.Pole - 228.10'
Mark R. Robinson in his 1995 survey found a capped iron witnessed by: West - Capped Iron - 33'
S15°E - Gas Marker Post - 114.07' S45°E - 12" Apple Tree - 91.40' S70°E - 48" Willow - 123.31'
Phil Case in 1997 survey found capped iron w/same witness as Robinson.

B. Description of corner evidence found and/or method applied in restoring or reestablishing corner:

K-10, Found Capped Iron of record, 2' East of Centerline on occupation line to the West, found no evidence of GLO or County Surveyor corner. This corner is accepted as a careful and faithful reestablishment of the position of the original Corner.

C. Description of monument for corner and accessories established to perpetuate locating the position of the corner:

K-10
Set Miss. County Mon., stamped #45505, 1999 on existing Iron
Fd Wit Tag 48" Willow-S70°E-123.30'
Fd Wit Tag in NE Side Tele Box Post - S11°E - 114.03'
Fd Wit Tag in N. Side 12" Apple-S37°E-92.05'
Iron & Cap-West-33.01'

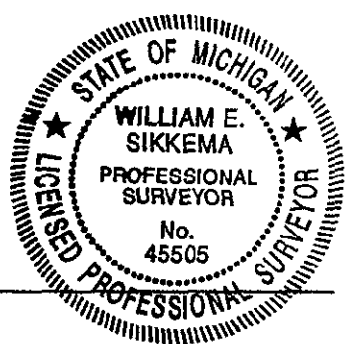

Signed by William E. Sikkema Date 11/03/99
Surveyor's Michigan License No. 45505

Peer Group Reviewed and Approved
Date: 12-9-99
J. Dean Geers
J. Dean Geers, Missaukee Co. Representative