

JAN 19 2000

LIBER 333 PAGE 422

# 1334

SECTION

LAND CORNER RECORDATION CERTIFICATE  
Filing Requirement of Act 74, Mich. P.A. 1970

For corners in

Missaukee (County)	Located in:	Corner Code #
1. Public Land Survey	T 21N R 07 W	K-11
	T _____ R _____	_____
	T _____ R _____	_____
	T _____ R _____	_____
2. Property Controlling in Section	S _____ T _____ R _____	_____
	S _____ T _____ R _____	_____
3. Miscellaneous Property in Sec.	S _____ T _____ R _____	_____
	S _____ T _____ R _____	_____

MISSAUKEE COUNTY MICHIGAN  
RECORDED DEC 09 1999 422M.  
*Carolyn Flare*  
REGISTER  
Register of Deeds Stamp & File  
Number

4. Lot No. \_\_\_\_\_, Recorded Plat \_\_\_\_\_  
5. Private Claims \_\_\_\_\_

I, William E. Sikkema, in a field survey on August 25, 19 99 do hereby state that under requirements of P.A. 74, Michigan P.A. of 1970, the corner points mentioned in lines 1 and 2 above were in conformance with regulations and rules therefore as required in the current manual of survey instructions of the United States Department of the Interior, Bureau of Land Management or by a decree of a Court of Law and/or that the corner points mentioned in lines 3, 4 and 5 above were in conformance with the rules of the Michigan Board of Land Surveyors or by a Decree of a Court of Law; established, re-established, monumented, recovered, found as expressed below:

	A	B	C	D	E	F	G	H	I	J	K	L	M
1													
2	6		5		4		3		2		1		
3													
4	7		8		9		10		11		12		
5													
6	18		17		16		15		14		13		
7													
8	19		20		21		22		23		24		
9													
10	30		29		28		27		26		25		
11													
12	31		32		33		34		35		36		
13													

NOTE: Not more than 2 corners, all in the same town and range, may be recorded on this certificate.

A. Description of original monument and accessories and/or subsequent restoration:

**K-11**, Section Corner common to Sections 25, 26, 35, & 36, T21N, R7W, was set by Deputy Surveyor, Colman in 1856. Corner witnessed by: N47°E - 12" Hemlock - 32 Links; S49°W - 12" Sugar Maple - 44 Links County Surveyor in 1893 used corner for survey in Section 36 with no witnesses given. County Surveyor visited the corner in 1894 for survey in Section 26 with no witnesses given. Misc. county survey records call for cedar stake, crockery, and plow point, wit. by N41°W-Cor. F. P.-55 links, N36 3/4°E-Cor. F. P.-50 1/2 links. Consumers Power Survey in 1963 - Set "T" iron by satisfying occupation lines along the N line of Section 35 and W 1/2 of the S line of Section 26, rather than double proportion which would have upset occupation lines in all four sections. Witnessed by: N53°E - Tel Riser Pole - 42.70' N47°W - Power Pole Stub - 45.87', S40 1/2°W - Power Pole - 44.76', Approx 5' N of CL E-W, in CL N, approx 4' W of CL S. Wilcox LCRC #706 of 1986 - fd "T" iron, witnessed by: S40°W - P. Pole - 44.83', N45°W - Powerline Stub Pole - 45.63, N55°E - Tel Stub Pole - 41.47', S25°E - Yield Sign Post - 52.84'. Paul Trinklein LCRC in 1997 - fd "T" iron of record, set 6" spike over "T" iron. Witnessed by: N57°E - Utility Ped Support - 43.18", N43°W - Utility Pole - 45.64', S44°W - Utility Pole - 44.78', S23°E - NW Face Turnerville & Meyering Rd Sign Post - 52.72'


B. Description of corner evidence found and/or method applied in restoring or reestablishing corner:

**K-11**, Found "T" Iron of record from Consumers Power Survey, 5' North of Centerline East-West, on Centerline North-South. Found no evidence of GLO or County Surveyor position. This corner is accepted as the best available evidence of the position of the original Corner.

C. Description of monument for corner and accessories established to perpetuate locating the position of the corner:

**K-11**  
Replaced "T" iron with 1/2" by 18" iron with Miss. County Mon., stamped #45505, 1999, in Mon. Box  
Fd wit. Tag SE of Tele Box Pole - N55°E - 43.47'  
Fd nail N Side of Power Pole - S40°W - 44.83'  
Fd nail SW Side of Power Pole - N45°W - 45.63'  
Yield Sign Post - S25°E - 52.84'

Signed by William E. Sikkema Date 11/03/99  
Surveyor's Michigan License No. 45505

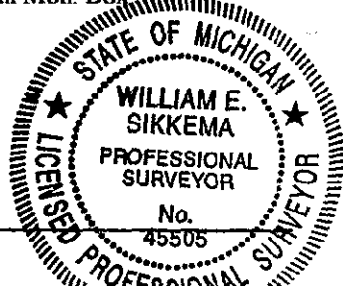

Peer Group Reviewed and Approved  
Date: 11-9-99  
J. Dean Beers  
J. Dean Beers, Missaukee Co. Representative