

JAN 13 2000

LIBER 333 PAGE 423

SECTION

LAND CORNER RECORDATION CERTIFICATE
Filing Requirement of Act 74, Mich. P.A. 1970

1335

For corners in

<u>Missaukee</u> (County)	Located In:	Corner Code #
1. Public Land Survey	T 21 N R 07 W	K-12
	T _____ R _____	_____
	T _____ R _____	_____
	T _____ R _____	_____
2. Property Controlling in Section	S _____ T _____ R _____	_____
	S _____ T _____ R _____	_____
3. Miscellaneous Property in Sec.	S _____ T _____ R _____	_____
	S _____ T _____ R _____	_____

MISSAUKEE COUNTY MICHIGAN
RECORDED DEC 09 1999 3:55 PM
Carolyn Flare
REGISTRAR
Register of Deeds Stamp & File Number

4. Lot No. _____, Recorded Plat _____
5. Private Claims _____

I, William E. Sikkema, in a field survey on August, 1999 do hereby state that under requirements of P.A. 74, Michigan P.A. of 1970, the corner points mentioned in lines 1 and 2 above were in conformance with regulations and rules therefore as required in the current manual of survey instructions of the United States Department of the Interior, Bureau of Land Management or by a decree of a Court of Law and /or that the corner points mentioned in lines 3, 4 and 5 above were in conformance with the rules of the Michigan Board of Land Surveyors or by a Decree of a Court of Law; established, re-established, monumented, recovered, found as expressed below:

1	A	B	C	D	E	F	G	H	I	J	K	L	M
2	6	5	4	3	2	1							
3													
4	7	8	9	10	11	12							
5													
6	18	17	16	15	14	13							
7													
8	19	20	21	22	23	24							
9													
10	30	29	28	27	26	25							
11													
12	31	32	33	34	35	36							
13													

NOTE: Not more than 2 corners, all in the same town and range, may be recorded on this certificate.

A. Description of original monument and accessories and/or subsequent restoration:


K-12, One-quarter Corner common to Sections 35 & 36, T21N, R7W, was set in 1856 by Deputy Surveyor Colman and witnessed by: N73°W - 32" Sugar Maple - 10 Links S42°E - Yellow Birch - 25 Links Beuthien Survey of Section 36 in 1893, No witnesses given.
Wilcox LCRC #706 Set 1/2" iron and cap in centerline of road N & S & E & W by doubling over 1/8th line position from 1893 Beuthien Survey from section corner to the North. Witnessed by:
N50°W - Corner Fence Post - 41.56' N20°W - Fence Post - 73.08'
S55°E - Corner Fence Post - 38.92' S65°W - P. Pole - 45.96'
Granger survey Liber S-3, page 181 of 1993 found 1/2" iron with no witnesses given.

B. Description of corner evidence found and/or method applied in restoring or reestablishing corner:

K-12, Found 1/2" iron of record in Centerline Intersection. Found no evidence of GLO or County Surveyor position. This corner is accepted as the best available evidence of the position of the original Corner.

C. Description of monument for corner and accessories established to perpetuate locating the position of the corner:

K-12
Set Miss. County Mon., stamped #45505, 1999, on existing iron
Set nail NE side cedar fence post - N50°W - 42.96'
Set nail NW side cedar fence post - N50°E - 40.27'
Set nail E S side fence post - S40°E - 45.10'
Set nail NW side power pole - S65°W - 46.40'

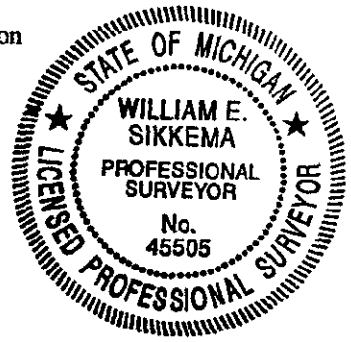

by William E. Sikkema Date 11/03/99 Surveyor's
Michigan License No. 45505

Peer Group Reviewed and Approved
Date: 12-9-99
J. Dean Geers
J. Dean Geers, Missaukee Co. Representative