

JAN 19 2000

LIBER 333 PAGE 424

LAND CORNER RECORDATION CERTIFICATE
Filing Requirement of Act 74, Mich. P.A. 1970

1336

SECTION

For corners in

Table with columns: Missaukee (County), Located In, Corner Code #. Rows include Public Land Survey, Property Controlling in Section, and Miscellaneous Property in Sec.

MISSAUKEE COUNTY MICHIGAN
RECORDED DEC 09 1999 3:55 PM
Register of Deeds Stamp & File Number

4. Lot No. , Recorded Plat
5. Private Claims

I, William E. Sikkema, in a field survey on August 15, 19 99 do hereby state that under requirements of P.A. 74, Michigan P.A. of 1970, the corner points mentioned in lines 1 and 2 above were in conformance with regulations and rules therefore as required in the current manual of survey instructions of the United States Department of the Interior, Bureau of Land Management or by a decree of a Court of Law and/or that the corner points mentioned in lines 3, 4 and 5 above were in conformance with the rules of the Michigan Board of Land Surveyors or by a Decree of a Court of Law, established, re-established, monumented, recovered, found as expressed below:

Grid table with columns A-M and rows 1-13. A dot is marked at the intersection of column I and row 9.

NOTE: Not more than 2 corners, all in the same town and range, may be recorded on this certificate.

A. Description of original monument and accessories and/or subsequent restoration:


L-9, One-quarter Corner common to Sections 24 & 25, T21N, R7W. Post originally set by Government Deputy Surveyor, Colman in 1856. Corner witnessed by: N60°E - 16" Hemlock - 16 Links S27°W - 16" Hemlock - 33 Links Corner visited by County Surveyor in 1900 and witnessed by: N52 1/2°E - Cedar Fence Post - 69 Links Consumers Power survey in 1963 set 1" solid rod by S.P. witnessed by: N49°W - Tel Pole - 73.26'; N60°E - 6" Cedar - 72.65' S66°E - 8" Cherry - 74.80'; S43°W - 6" Birch - 57.35'; 3" East of Fence to North; 0.5' North of Centerline. Phil Case Cert. Of Survey 1997 & LCRC of Trinklien #43072, fd 1 1/4" sq. bolt (bent) in CL road E-W, extension of fence line North is approx. 6' West, set 1/2" x 18" bar & cap in exact location of bolt, witnessed by: N72°E - 16" Cedar - 86.94' S63°E - utility pole - 92.91' S33°W - 11" Cherry - 60.72' N15°E - 11' birch clump - 40.95'

B. Description of corner evidence found and/or method applied in restoring or reestablishing corner:

L-9, Found Iron & Cap #30079 of record, Consumers Power position of the corner falls 2.90' Westerly as established from distances between Section corners, fence line witness to the North, and Cedar witness, all other witnesses have been removed. It appears that the Corner was moved during road reconstruction and was reset incorrectly by Trinklien. According to Kelly Bekken of the Missaukee County Road Commission no effort was given to preserve the corner locations during construction. Reset Consumers Power location by Single Proportionate measure. Removed Iron & Cap #30079. This corner is accepted as a careful and faithful reestablishment of the position of the original Corner.

C. Description of monument for corner and accessories established to perpetuate locating the position of the corner:

- L-9
Set 1/2" by 18" iron with Miss. County Mon., stamped #45505, 1999 in Mon. Box
Fd nail SE side of 16" Cedar - N70°E - 89.25'
Fd nail NE side power pole - S65°E - 95.75'
Fd nail NW side 11" Cherry - S30°W - 59.85'
Fd nail W side 11" Birch Clump - N20°E - 40.80'
Set nail S side 16" Cedar - N65°E - 72.40'

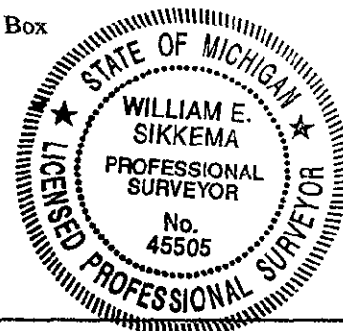

Signed by William E. Sikkema
Surveyor's Michigan License No. 45505

Date 11/03/99

Peer Group Reviewed and Approved
Date: 12-9-99
J. Dean Geers, Missaukee Co. Representative