

JAN 19 2000

LIBER 333 PAGE 425

LAND CORNER RECORDATION CERTIFICATE
Filing Requirement of Act 74, Mich. P.A. 1970

1337

SECTION

For corners in

Table with columns: Missaukee (County), Located In, Corner Code #. Rows include Public Land Survey, Property Controlling in Section, and Miscellaneous Property in Sec.

MISSAUKEE COUNTY MICHIGAN
RECORDED DEC 09 1999 3:55 P.M.
Register of Deeds Stamp & File Number

4. Lot No. , Recorded Plat
5. Private Claims

I, William E. Sikkema, in a field survey on August 15, 19 99, do hereby state that under requirements of P.A. 74, Michigan P.A. of 1970, the corner points mentioned in lines 1 and 2 above were in conformance with regulations and rules therefore as required in the current manual of survey instructions of the United States Department of the Interior, Bureau of Land Management or by a decree of a Court of Law and /or that the corner points mentioned in lines 3, 4 and 5 above were in conformance with the rules of the Michigan Board of Land Surveyors or by a Decree of a Court of Law; established, re-established, monumented, recovered, found as expressed below:

Grid table with columns A-M and rows 1-13. A dot is present in cell J11.

NOTE: Not more than 2 corners, all in the same town and range, may be recorded on this certificate.

A. Description of original monument and accessories and/or subsequent restoration:


L-11, One-quarter Corner common to Sections 25 & 36, T21N, R7W, was originally set in 1856 by Deputy Surveyor, Colman, witnessed by: N70°E - 12" Hemlock - 18 Links S33°W - 30" Hemlock - 44 Links
County Surveyor visited this corner in 1893 in survey of Section 36 - no witnesses given.
Consumers Power Survey in 1963 - Fd 1" iron 1' down. Witnessed by: N - T Iron - 33'; S76 1/2°E - P. Pole - 152.40, S79°W - P. Pole - 14.67'; apprx. 3' N of CLE-W, in line with fence to the N.
Paul Trinklein LCRC in 1997 found 3/4" I.P. Pipe 20" below surface, raised with 1/2" x 18" bar and cap#30079. Witnessed by: N31E - Utility Pole - 30.95', N05°E Consumers Power "T" iron - 32.97', N03°W - 10" R. Pine - 45.71', N11°W - 10" R. Pine - 39.88, S25°E - 13" R. Pine - 56.39', S30°W - 10" R. Pine - 45.88'

B. Description of corner evidence found and/or method applied in restoring or reestablishing corner:

L-11, Found Bar & Cap #30079 of record, position fits distances from Consumers Power Survey, On tree line to the North, 5' North of Centerline East-West. This corner is accepted as the best available evidence of the position of the original Corner.

C. Description of monument for corner and accessories established to perpetuate locating the position of the corner:

L-11
Set Miss. County Mon., stamped #45505, 1999, on existing iron, added Mon. Box
Fd nail SE side power pole - N31°E - 30.95'
Fd nail SW side 13" R. Pine - S25°E - 56.39'
Fd nail NW side 10" R. Pine - S30°W - 45.88'
Fd Consumers Power T iron & Tag - N05°E - 32.97'
Fd PK S side 10" R. Pine - N11°W - 39.88'

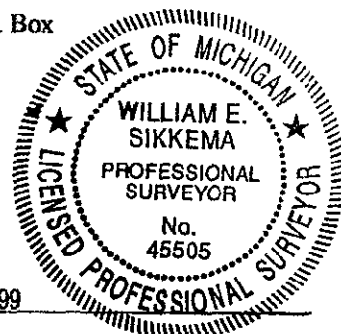

Signed by William E Sikkema Date 11/03/99

Surveyor's Michigan License No. 45505

Peer Group Reviewed and Approved
Date: 10-9-99
J. Dean Geers, Missaukee Co. Representative