

**SURVEY &  
REMONUMENTATION**

MAY 28 1997

LIBER 308 PAGE 711

**COMMISSION LAND CORNER RECORDATION CERTIFICATE**  
Filing Requirement of Act 74, Mich. P.A. 1970

# 1080

For corners in Missaukee (County) Located in: \_\_\_\_\_ Corner Code # \_\_\_\_\_

1. Public Land Survey	T <u>21N</u> R <u>7W</u>	<u>M-2</u>
	T _____ R _____	_____
	T _____ R _____	_____
	T _____ R _____	_____
2. Property Controlling in Section	S _____ T _____ R _____	_____
	S _____ T _____ R _____	_____
3. Miscellaneous Property in Section	S _____ T _____ R _____	_____
	S _____ T _____ R _____	_____

4. Lot No. \_\_\_\_\_, Recorded Plat \_\_\_\_\_

5. Private Claims \_\_\_\_\_

MISSAUKEE COUNTY MICHIGAN

RECORDED **DEC 20 1996** 9:45 #M.

*Caryn Flare*  
REGISTER

Register of Deeds Stamp & File Number

	A	B	C	D	E	F	G	H	I	J	K	L	M
2	6	5	4	3	2	1							
3													
4	7	8	9	10	11	12							
5													
6	18	17	16	15	14	13							
7													
8	19	20	21	22	23	24							
9													
10	30	29	28	27	26	25							
11													
12	31	32	33	34	35	36							
13													

I, J. Dean Geers, in a field survey on December, 1996, do hereby certify that under requirements of P.A. 74, Michigan P.A. of 1970, the corner points mentioned in lines 1 and 2 above were in conformance with regulations and rules therefore as required in the current manual of survey instructions of the United States Department of the Interior, Bureau of Land Management or by a decree of a Court of Law and/or that the corner points mentioned in lines 3, 4 and 5 above were in conformance with the rules of the Michigan Board of Professional Surveyors or by a Decree of a Court of Law; established, re-established, monumented, re-monumented, recovered, found as expressed below:

**NOTE: Not more than 4 corners, all in the same town and range, may be recorded on this certificate.**


- A. Description of original monument and accessories and/or subsequent restoration:**
- M-2) 1837 GLO Quarter Section Post by John Brink, Deputy Surveyor; Yellow Pine 16-S26 1/2W-40; Yellow Pine 16-N40 1/2W-53
  - M-2) 1892 & 1910 Beuthien Survey in Section 6, T21N, R6W; 2" Well Pipe and Stone, WPS 20-S31E-80'; Corner of Res.-N44.15E-80.5'
  - M-2) 1910 Beuthien Survey in Section 1, T21N, R7W; Old stake ok, WPS 26-S33E-125
  - M-2) 1975 Wilcox Survey in Section 6, T21N, R6W; Corner was used, no Wit's recorded
  - M-2) 1977 Wilcox LCRC, Liber 1, pg. 528; Found 1/2" Iron S50E-P.P.-72.33; S40E-8" White Pine-92.24; N45E-12" Maple-57.91; N15E-8" Poplar-72.69
- (Cont. on Back)

- B. Description of corner evidence found and/or method applied in restoring or reestablishing corner:**
- M-2) Corner Common to Section 1, T21N, R7W and Section 6, T21N, R6W, Found Iron of record 2'± Northerly of Centerline Road to East, 4'± Westerly Centerline Road to South, 1'± Westerly of Centerline Road to the North, 5'± Northerly Centerline Drive to the West. This Corner is accepted as a careful and faithful perpetuation of the position of the original corner.

- C. Description of monument for corner and accessories established to perpetuate locating the position of the corner:**
- M-2) Set Missaukee Co. Mon. on existing Iron in Mon. Box  
S50E - 72.34 - Power Pole  
S40E - 92.30 - 12" White Pine  
N45E - 57.96 - 12" Maple  
N45W - 50.21 - Power Pole

Peer Group Reviewed and Approved  
Date: 12-19-96  
*J. Dean Geers*  
J. Dean Geers, Missaukee Co. Representative

Signed by *J. Dean Geers*  
Surveyor's Michigan License No. 33977

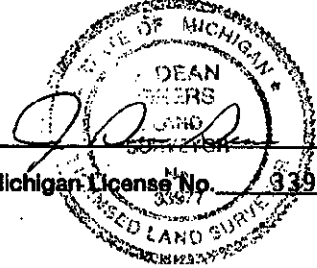

SURVEY &  
REMONUMENTATION

MAY 28 1997

COMMISSION

LIBER 308 PAGE 711-A

(Cont. from A on front of sheet)

- M-2) 1977 Wilcox Survey, Liber S-1, pg. 374; Found 1/2" Iron
- M-2) 1977 Wilcox Survey, Liber S-2, pg. 36; Found 1/2" Iron
- M-2) 1981 Wilcox Survey, Liber S-2, pg. 69; Found 1/2" Iron
- M-2) 1991 Wilcox Survey, Liber S-3, pg. 155; Found 1/2" Iron
- M-2) 1993 Wilcox Survey, Liber S-3, pg. 202; Found 1/2" Iron N45W-50.18-P.P.; N58E-58.00-14" Maple; S58E-72.35-Utility Pole; N80E-54.00-"x" in North end Headwall