

JAN 19 2000

SECTION

LIBER 333 PAGE 451

LAND CORNER RECORDATION CERTIFICATE
Filing Requirement of Act 74, Mich. P.A. 1970

For corners in

1364

Missaukee County (County)	Located In:	Corner Code #
1. Public Land Survey	T 21N R 8W	G-10
	T ___ R ___	_____
	T ___ R ___	_____
	T ___ R ___	_____
2. Property Controlling in Section	S ___ T ___ R ___	_____
	S ___ T ___ R ___	_____
3. Miscellaneous Property in Sec.	S ___ T ___ R ___	_____
	S ___ T ___ R ___	_____

MISSAUKEE COUNTY MICHIGAN

RECORDED DEC 09 1999 4:10 PM

Paula Flor

Register of Deeds Stamp & File Number

4. Lot No. _____, Recorded Plat _____
5. Private Claims _____

I, Daniel E. Schripsema, in a field survey on October 1, 1999 do hereby state that under requirements of P.A. 74, Michigan P.A. of 1970, the corner points mentioned in lines 1 and 2 above were in conformance with regulations and rules therefore as required in the current manual of survey instructions of the United States Department of the Interior, Bureau of Land Management or by a decree of a Court of Law and for that the corner points mentioned in lines 3, 4 and 5 above were in conformance with the rules of the Michigan Board of Land Surveyors or by a Decree of a Court of Law; established, re-established, monumented, recovered, found as expressed below:

	A	B	C	D	E	F	G	H	I	J	K	L
1												
2	6		5		4		3		2			1
3												
4	7		8		9		10		11			12
5												
6	13		17		16		15		14			18
7												
8	19		20		21		22		23			24
9												
10	30		29		28		27		26			25
11												
12	31		32		33		34		35			36
13												

NOTE: Not more than 2 corners, all in the same town and range, may be recorded on this certificate.

A. Description of original monument and accessories and/or subsequent restoration:

- G-10 - GLO - Set Post
Sugar 14" N.33 1/4 W.19
Sugar 12" S.86 E.21
- Co. Surveyor Notes - Book 36, Page 55 - May 7, 1894
Sugar 20" S. 18. W. 73.
- LCRC #816 - James A. Ray - Jan. 20, 1990 - Found 1/2" Iron Centerline Rd.
S80W T. Ctr. Tel. Ped. 39.4
Cor. is in Centerline Rd. on old FE Lines E-W. 1/2 Way and on line between Sec. corners.
- Record Survey - L. S-3, Page 19 - Wade-Trim/Granger - Aug 7, 1990

B. Description of corner evidence found and/or method applied in restoring or reestablishing corner:


Found 1/2" Iron approximately 1' East of centerline N-S road. This corner is accepted as the best available evidence of the position of the original corner.

C. Description of monument for corner and accessories established to perpetuate locating the position of the corner:

Placed Missaukee County Monument on top of iron.

WITNESSES

- N04W 321.49' Power Pole
- N10E 326.28' Power Pole
- S39W 118.24' Fd. Nail in Power Pole
- S85W 39.37' Centerline of Top of tel. Ped.

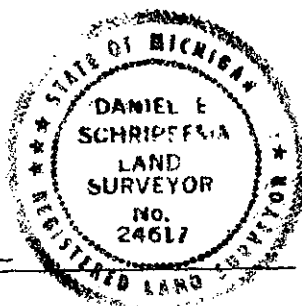

Peer Group Reviewed and Approved

Date: 12-9-99
J. Dean Geers
J. Dean Geers, Missaukee Co. Representative

Signed by Daniel E. Schripsema
Surveyor's Michigan License No. 24617

Date 12-2-99