

JAN 19 2000

LIBER 333 PAGE 449

SECTION

LAND CORNER RECORDATION CERTIFICATE
Filing Requirement of Act 74, Mich. P.A. 1970

#1362

For corners in

Missaukee County (County)	Located In:	Corner Code #
1. Public Land Survey	T 21N R 8W	G-12
	T R	
	T R	
	T R	
2. Property Controlling in Section	S T R	
	S T R	
3. Miscellaneous Property in Sec.	S T R	
	S T R	

MISSAUKEE COUNTY MICHIGAN
RECORDED DEC 09 1999 *49M*
Paula Flare
Register of Deeds Stamp & File
Number

4. Lot No. _____, Recorded Plat _____
5. Private Claims _____

I, Daniel E. Schripsema, in a field survey on October 1, 1999 do hereby state that under requirements of P.A. 74, Michigan P.A. of 1970, the corner points mentioned in lines 1 and 2 above were in conformance with regulations and rules therefore as required in the current manual of survey instructions of the United States Department of the Interior, Bureau of Land Management or by a decree of a Court of Law and /or that the corner points mentioned in lines 3, 4 and 5 above were in conformance with the rules of the Michigan Board of Land Surveyors or by a Decree of a Court of Law; established, re-established, monumented, recovered, found as expressed below:

	A	B	C	D	E	F	G	H	I	J	K	L
1												
2	6			5			4			3		2
3												1
4	7			8			9			10		11
5												
6	18			17			16			15		14
7												
8	19			20			21			22		23
9												
10	30			29			28			27		26
11												
12	31			32			33			34		35
13												

NOTE: Not more than 2 corners, all in the same town and range, may be recorded on this certificate.

A. Description of original monument and accessories and/or subsequent restoration:

- G-12 - GLO - Set Post
 - Beech 6" N.11 W.10
 - Sugar 16" S.44 E.35
- Daniel E. Schripsema - Job No. 98160 - Nov. 25, 1998
 - Fd. Iron and Cap by McClung
 - 16" Basswood N50E 43.40
 - 14" Maple S50E 37.95
 - 12" Maple S07E 24.00
 - 6" Maple S85W 17.62

B. Description of corner evidence found and/or method applied in restoring or reestablishing corner:

Found 3/4" bar and cap set by McClung. This corner is accepted as the best available evidence of the position of the original corner.

C. Description of monument for corner and accessories established to perpetuate locating the position of the corner:


Placed Missaukee County Monument on top of iron.

WITNESSES

- 16" Basswood N50E 43.40'
- 14" Maple S50E 37.95'
- 12" Maple S07E 24.00'
- 6" Maple S85W 17.62'

Peer Group Reviewed and Approved

Date: 12-9-99
J. Dean Geers
J. Dean Geers, Missaukee Co. Representative

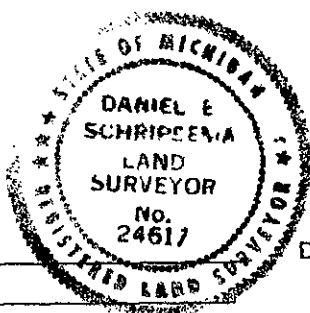

Signed by Daniel E. Schripsema
Surveyor's Michigan License No. 24617

Date 12-2-99