SURVEY & REMONUMENTATION

DEC 27 1993

COMMISSION

#907

LAND CORNER RECORDATION CERTIFICATE
Filing Requirement of Act 74, Mich. P.A. 1970

LIBER 283 PAGE 433

For corners in Missaukee (County)

	Located In:	Corner Code #
1. Public Land Survey	T 21N R 8W	G-13
	T ___ R ___	
	T ___ R ___	
	T ___ R ___	
2. Property Controlling	S ___ T ___ R ___	
in Section	S ___ T ___ R ___	
3. Miscellaneous	S ___ T ___ R ___	
Property in Sec.	S ___ T ___ R ___	

MISSAUKEE COUNTY MICHIGAN
RECORDED DEC 16 1993 12:40 P.M.
Carolyn Flore
REGISTER

Register of Deeds Stamp & File Number

4. Lot No. _____, Recorded Plat _____
5. Private Claims _____

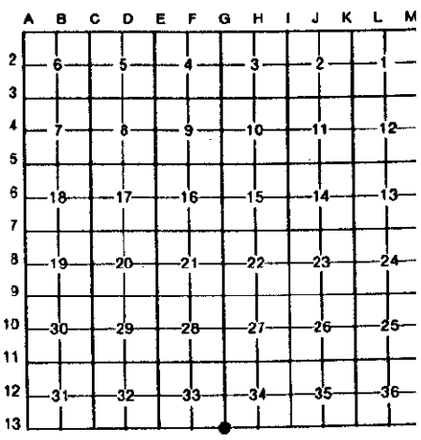

I, J. Dean Geers, in a field survey on December 13, 19 93, do hereby certify that under requirements of P.A. 74, Michigan P.A. of 1970, the corner points mentioned in lines 1 and 2 above were in conformance with regulations and rules therefore as required in the current manual of survey instructions of the United States Department of the Interior, Bureau of Land Management or by a decree of a Court of Law and/or that the corner points mentioned in lines 3, 4 and 5 above were in conformance with the rules of the Michigan Board of Land Surveyors or by a Decree of a Court of Law; established, re-established, monumented, re-monumented, recovered, found as expressed below:

NOTE: Not more than 4 corners, all in the same town and range, may be recorded on this certificate.

A. Description of original monument and accessories and/or subsequent restoration:

G-13) 1837 GLO Section post by John Brink, Deputy Surveyor
Sugar 14 N 86° E 25, Beech 22 N 45° W 4

G-13) Beuthien survey notes: Corner of 33 and 34 on town line, Sugar 5 N 27 1/4° W 52

B. Description of corner evidence found and/or method applied in restoring or reestablishing corner:

G-13) Section corner common to Sections 33 and 34

Found rotted remains of Cedar stake ±10" below the road surface in the centerline of the East-West road, opposite the tree line to the North and approximately 34.3' Southeasterly of a 24" Maple believed to be the Beuthien witness tree. This corner is accepted as a careful and faithful perpetuation of the position of the original corner.

C. Description of monument for corner and accessories established to perpetuate locating the position of the corner:

G-13) Set 1/2" x 36" Iron and Missaukee County monument in a monument box at the center of the rotted Cedar stake.

N 46° W - 54.70 - 30" Maple
N 19° W - 34.85 - 24" Maple
N 33° E - 36.58 - 36" Maple
N 68° E - 73.78 - 36" Maple

Peer Group Reviewed and Approved
Date: 12-15-93
J. Dean Geers, Missaukee Co. Representative

Signed by J. Dean Geers Date 12/15/93
Surveyor's Michigan License No. 33977

FORM APPROVED BY MICHIGAN STATE BOARD OF LAND SURVEYORS, JAN. 28, 19
REVISED MAY 14, 19
REVISED JAN., 19