

JAN 19 2000

SECTION

LIBER 333 PAGE 446

LAND CORNER RECORDATION CERTIFICATE  
Filing Requirement of Act 74, Mich. P.A. 1970

For corners in

Missaukee County  
(County)

Located In:

Corner Code #

1. Public Land Survey

T 21N R 8W

K-10

T R

T R

T R

2. Property Controlling  
in Section

S

T R

3. Miscellaneous  
Property in Sec.

S

T R

S

T R

S

T R

4. Lot No. \_\_\_\_\_, Recorded Plat \_\_\_\_\_

5. Private Claims \_\_\_\_\_

# 1359

MISSAUKEE COUNTY MICHIGAN

RECORDED DEC 09 1999 4:20 PM

*Carolyn Flare*

Register of Deeds Stamp & File Number

	A	B	C	D	E	F	G	H	I	J	K	L
1												
2	6		5		4		3		2		1	
3												
4	7		8		9		10		11		12	
5												
6	18		17		16		15		14		13	
7												
8	19		20		21		22		23		24	
9												
10	30		29		28		27		26		25	
11												
12	31		32		33		34		35		36	
13												

I, Daniel E. Schripsema, in a field survey on October 1, 1999 do hereby state that under requirements of P.A. 74, Michigan P.A. of 1970, the corner points mentioned in lines 1 and 2 above were in conformance with regulations and rules therefore as required in the current manual of survey instructions of the United States Department of the Interior, Bureau of Land Management or by a decree of a Court of Law and for that the corner points mentioned in lines 3, 4 and 5 above were in conformance with the rules of the Michigan Board of Land Surveyors or by a Decree of a Court of Law; established, re-established, monumented, recovered, found as expressed below:

NOTE: Not more than 2 corners, all in the same town and range, may be recorded on this certificate.

A. Description of original monument and accessories and/or subsequent restoration:

K-10 - GLO - Set Post

12" Sugar S.51 1/2 E.23 ; 10" Sugar S.38 1/2 W.12

-Co. Surveyor Notes - Oct. 8, 1890

Corner shown as no witnesses

- Co. Surveyor Notes - Book 8, Page 40 - May 9, 1919

Set Iron Post ; Tel. Pole S.29 1/4 W.56 ; Cor. Fence Post N.45 W.54

- LCRC #675 - Matthew A. McClung - Dec. 2, 1982 - Found Rail Road spike on top of Iron P. Pole N45E 44.00 ; P. Pole N65W 92.60

B. Description of corner evidence found and/or method applied in restoring or reestablishing corner:

Found R.R. Spike on top of iron ± 2' W Centerline of N-S Rd. - ± 2' S. Centerline of E-W Rd. This corner is accepted as the best available evidence of the position of the original corner.

C. Description of monument for corner and accessories established to perpetuate locating the position of the corner:  
Placed Missaukee County Monument on top of iron.


WITNESSES

- N67W 92.52' Fd. nail in Power Pole
- S55W 104.19' Fd. nail & bolt in Power Pole
- N43E 44.22' Fd. nail in Power Pole
- N82E 285.98' set nail in 38" Maple

Peer Group Reviewed and Approved

Date: 12-2-99  
*J. Dean Geers*  
J. Dean Geers, Missaukee Co. Representative

Signed by Daniel E. Schripsema  
Surveyor's Michigan License No. 24617

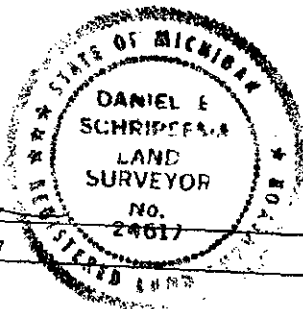

Date 12-2-99