

JAN 19 2000

LIBER 333 PAGE 444

SECTION

LAND CORNER RECORDATION CERTIFICATE

Filing Requirement of Act 74, Mich. P.A. 1970

1357

For corners in

<u>Missaukee County</u> (County)	Located In:	Corner Code #
1. Public Land Survey	T 21N R 8W	K-11
	T ___ R ___	_____
	T ___ R ___	_____
	T ___ R ___	_____
2. Property Controlling in Section	S ___ T ___ R ___	_____
	S ___ T ___ R ___	_____
3. Miscellaneous Property in Sec.	S ___ T ___ R ___	_____
	S ___ T ___ R ___	_____

MISSAUKEE COUNTY MICHIGAN
RECORDED DEC 09 1999 4:10 PM
Carolyn Flare
REGISTER
Register of Deeds Stamp & File
Number

4. Lot No. _____, Recorded Plat _____
5. Private Claims _____

I, Daniel E. Schripsema, in a field survey on October 1, 1999 do hereby state that under requirements of P.A. 74, Michigan P.A. of 1970, the corner points mentioned in lines 1 and 2 above were in conformance with regulations and rules therefore as required in the current manual of survey instructions of the United States Department of the Interior, Bureau of Land Management or by a decree of a Court of Law and /or that the corner points mentioned in lines 3, 4 and 5 above were in conformance with the rules of the Michigan Board of Land Surveyors or by a Decree of a Court of Law; established, re-established, monumented, recovered, found as expressed below:

A	B	C	D	E	F	G	H	I	J	K	L
1											
2	6		5		4		3		2		1
3											
4	7		8		9		10		11		12
5											
6	18		17		16		15		14		13
7											
8	19		20		21		22		23		24
9											
10	30		29		28		27		26		25
11											
12	31		32		33		34		35		36
13											

NOTE: Not more than 2 corners, all in the same town and range, may be recorded on this certificate.

A. Description of original monument and accessories and/or subsequent restoration:

K-11 - GLO - Set Post
20" Sugar S.31 1/2 E.40 ; 18" Sugar N.63 1/4 E.38
- Co. Surveyor Notes - Book 8, Page 40 - May 9, 1919
Set Iron Post ; SE Cor. of Bldg. N.49 W.195 ; Tel. Pole S.29 1/2 W.80
- LCRC #675 - Matthew A. McClung - Dec. 2, 1982 - Found 1/4" Steel Bar
Tel. Riser N45E 52.05 ; 4'x4' Rock (center) N78W 177.35

B. Description of corner evidence found and/or method applied in restoring or reestablishing corner:

Found 3/4" bar ± 3' W Centerline of N-S Rd. - ± Centerline of E-W Rd. This corner is accepted as the best available evidence of the position of the original corner.

C. Description of monument for corner and accessories established to perpetuate locating the position of the corner:


Placed Missaukee County Monument on top of iron.

WITNESSES

N46E 51.91' Top center of Phone Riser
S66E 224.86' set nail in Power Pole
N26W 190.68' set nail in Power Pole
S53W 119.95' fd. bolt in Power Pole

Peer Group Reviewed and Approved

Date: 12-2-99
J. Dean Gears
J. Dean Gears, Missaukee Co. Representative

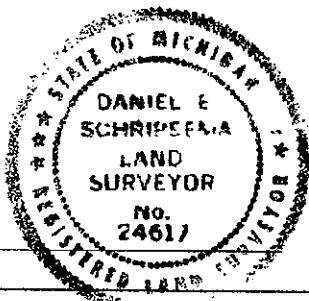

Signed by *Daniel E. Schripsema*
Surveyor's Michigan License No. 24617

Date 12-2-99