

JAN 19 2000

LIBER 333 PAGE 455

SECTION

LAND CORNER RECORDATION CERTIFICATE

Filing Requirement of Act 74, Mich. P.A. 1970

For corners in

Missaukee County (County) Located In: Corner Code #

1. Public Land Survey T 21N R 8W K-12
 T R
 T R
 T R

2. Property Controlling in Section S T R
 S T R

3. Miscellaneous Property in Sec. S T R
 S T R

#1368

MISSAUKEE COUNTY MICHIGAN
 RECORDED DEC 09 1999 4:10 PM
Pauline Flare
 Register of Deeds Stamp & File Number

4. Lot No. _____, Recorded Plat _____
 5. Private Claims _____

I, Daniel E. Schripsema, in a field survey on October 1, 1999 do hereby state that under requirements of P.A. 74, Michigan P.A. of 1970, the corner points mentioned in lines 1 and 2 above were in conformance with regulations and rules therefore as required in the current manual of survey instructions of the United States Department of the Interior, Bureau of Land Management or by a decree of a Court of Law and /or that the corner points mentioned in lines 3, 4 and 5 above were in conformance with the rules of the Michigan Board of Land Surveyors or by a Decree of a Court of Law; established, re-established, monumented, recovered, found as expressed below:

	A	B	C	D	E	F	G	H	I	J	K	L
1												
2	6		5		4		3		2			1
3												
4	7		8		9		10		11			12
5												
6	18		17		16		15		14			13
7												
8	19		20		21		22		23			24
9												
10	30		29		28		27		26			25
11												
12	31		32		33		34		35			36
13												

NOTE: Not more than 2 corners, all in the same town and range, may be recorded on this certificate.

A. Description of original monument and accessories and/or subsequent restoration:

- K-12 - GLO - Set Post
 - 16" Sugar S.16 1/2 E.13
 - 10" Sugar S.61 W.33
- LCRC #720 - Matthew A. McClung - July 24, 1985 - Set 5/8" iron w/ cap per occupation
 - 10" Cedar N63E 65.40
 - 10" Elm S59E 58.10

B. Description of corner evidence found and/or method applied in restoring or reestablishing corner:

Found 5/8" Iron with Cap Remains ± 1' W. Centerline N-S Rd. This corner is accepted as the best available evidence of the position of the original corner.

C. Description of monument for corner and accessories established to perpetuate locating the position of the corner:

Placed Missaukee County Monument on top of iron.


WITNESSES

- N62E 65.31' set nail - 20" Cedar
- N89W 50.45' set nail - Cor. Fence Post
- N32E 57.85' set nail - Power Pole
- S60E 57.30' set nail - 24" Elm
- S46E 45.08' Cor. Fence Post (no nail)

Peer Group Reviewed and Approved

Date: 12-9-99
J. Dean Geers
 J. Dean Geers, Missaukee Co. Representative

Signed by Daniel E. Schripsema
 Surveyor's Michigan License No. 24617

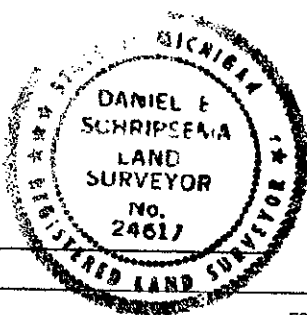

Date 12-4-99