

JAN 13 2000

LIBER 333 PAGE 432

SECTION

LAND CORNER RECORDATION CERTIFICATE
Filing Requirement of Act 74, Mich. P.A. 1970

# 1344

For corners in

Form with fields for Missaukee County, Located In, Corner Code #, and numbered sections 1-5 for Public Land Survey, Property Controlling, etc.

MISSAUKEE COUNTY MICHIGAN

RECORDED DEC 09 1999 4 PM

Handwritten signature of Carolyn Klare, REGISTER

Register of Deeds Stamp & File Number

I, J. Dean Geers, P.S., in a field survey on June, 19 99 do hereby state that under requirements of P.A. 74, Michigan P.A. of 1970, the corner points mentioned in lines 1 and 2 above were in conformance with regulations and rules therefore as required in the current manual of survey instructions of the United States Department of the Interior, Bureau of Land Management or by a decree of a Court of Law and /or that the corner points mentioned in lines 3, 4 and 5 above were in conformance with the rules of the Michigan Board of Land Surveyors or by a Decree of a Court of Law; established, re-established, monumented, recovered, found as expressed below:

Grid table with columns A-L and rows 1-13, containing numerical values for corner points.

NOTE: Not more than 2 corners, all in the same town and range, may be recorded on this certificate.

A. Description of original monument and accessories and/or subsequent restoration:

- List of survey details including H-13 1837 GLO Quarter Section Post by John Brink, Deputy Surveyor, 13" White Pine-N48E-23 lks, 15" White Pine-N28 1/2 W-23 lks, etc.

B. Description of corner evidence found and/or method applied in restoring or reestablishing corner:

H-13) Quarter section corner common to Section 34, T22N, R5W and Section 3, T21N, R5W. Found 1/2" rod as recorded in Liber 1, Page 801 and wagon skein 7.14' West. Upon investigation it was determined that the wagon skein was the best available evidence of the original corner.


C. Description of monument for corner and accessories established to perpetuate locating the position of the corner:

- H-13) Found wagon skein and added 1/2"x18" rebar and Missaukee County monument. S44W 49.21 Found nail in Northwest face, 10" Red Pine, etc.

Peer Group Reviewed and Approved

Date: 12-9-99 J. Dean Geers, Missaukee Co. Representative

Signed by [Signature] Surveyor's Michigan License No. 33977

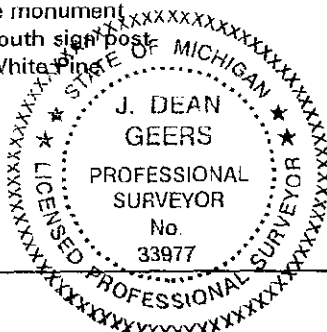

Date 11-23-99