

RECORDED

JAN 19 2000

LIBER 333 PAGE 433

LAND CORNER RECORDATION CERTIFICATE
Filing Requirement of Act 74, Mich. P.A. 1970

SECTION

#1345

For corners in

Missaukee County

Located In:

Corner Code #

- 1. Public Land Survey T 22N R 05W I-13
2. Property Controlling in Section S T R
3. Miscellaneous Property in Sec. S T R

MISSAUKEE COUNTY MICHIGAN

RECORDED DEC 09 1999

Handwritten signature: Carolyn Flare

REGISTRAR

Register of Deeds Stamp & File Number

4. Lot No. , Recorded Plat

5. Private Claims

I, J. Dean Geers, P.S., in a field survey on June, 19 99 do hereby state that under requirements of P.A. 74, Michigan P.A. of 1970, the corner points mentioned in lines 1 and 2 above were in conformance with regulations and rules therefore as required in the current manual of survey instructions of the United States Department of the Interior, Bureau of Land Management or by a decree of a Court of Law and /or that the corner points mentioned in lines 3, 4 and 5 above were in conformance with the rules of the Michigan Board of Land Surveyors or by a Decree of a Court of Law; established, re-established, monumented, recovered, found as expressed below:

NOTE: Not more than 2 corners, all in the same town and range, may be recorded on this certificate.

A. Description of original monument and accessories and/or subsequent restoration:

- I-13) 1837 GLO Section Post by John Brink, Depury Surveyor; 10" Beech-S40W-43 lks, 6" Beech-S40E-25 lks.
I-13) 1852 GLO Section Post recovered by A. Curtis, Deputy Surveyor; 10" Beech-S40W-43 lks, 6" Beech-S40E-25 lks.
I-13) 1912 Beuthien Survey; Wagon skein. WPS 34"-S71E-130 lks, Telephone pole-N28W-47 lks.
I-13) 1914 Beuthein Survey; Wagon skein. 36" White Pine stump-S71E-138 lks, 8" Telephone pole-N28W-47 lks.
I-13) 1938 Schaaf Notes: Found post.
I-13) 1939 Arthur Survey; No monument described. 10" Beech-S40W-43', 6" Beech-S40E-25'.
I-13) 1961 Ken Ostling Notes: Restored corner from 1914 Beuthien witness.

Grid table with columns A-M and rows 1-13. Contains numbers 1-36 in a grid pattern.

A continued on back

B. Description of corner evidence found and/or method applied in restoring or reestablishing corner:


- I-13) Section corner common to Sections 34 and 25, T22N, R5W and Sections 2 and 3, T21N, R5W. Found 5/8" rod as recorded in Liber 1, Page 804. Corner is +/- 5' South of centerline East-West Road and +/- 4' West of centerline Road to North. This corner is accepted as the best available evidence of the position of the original corner. Also found 1/2" iron +/- 4.5' North of the corner. This corner was not accepted.

C. Description of monument for corner and accessories established to perpetuate locating the position of the corner:

- I-13) Found 5/8" rod and added Missaukee County Monument.

- \*N25W 66.46' Found nail in Northeast face 8" Fir
\*S52W 36.52' Found spike in South face Tele riser post
\*S27E 33.39' Found spike in East face 10" oak
\*N43E 55.30' Found spike in West face Tele riser post
N12W 55.6' Sign post
\*N26W 126.05' Southeast corner of hse
\*S52W 74.5' Birch stump

\*Previous Witness

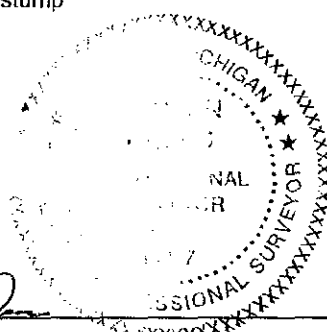

Peer Group Reviewed and Approved

Date: 12-9-99
J. Dean Geers, Missaukee Co. Representative

Signed by [Signature]
Surveyor's Michigan License No. 33977

Date 11-23-99