

LAND CORNER RECORDATION CERTIFICATE

FILING REQUIREMENT OF ACT 74, MICH. P.A.1970

FOR CORNERS OF--:	LOCATED IN--:	CORNER CODE NUMBER
1. PUBLIC LAND SURVEY.....	T. 22 N. R. 6 W.	J-9; K-8
2. PROPERTY CONTROLLING IN SECTION.....	23 T. 22 N. R. 6 W.	7; 14
3. MISCELLANEOUS PROPERTY IN SECTION.....	T. N. R. E. S. R. W.	
4. LOT NO., RECORDED PLAT.....		
5. PRIVATE CLAIMS.....		

REGISTER OF DEEDS STAMP AND FILING NUMBER

I, Kenneth J. Ostling, do hereby certify that under requirements of P.A. 74, Michigan P.A. of 1970, the corner points mentioned in lines 1 and 2 above were, in a field survey on May 28, 1980, established, re-established, monumented, re-monumented, recovered or restored as expressed below and in conformance with regulations and rules therefore as required in the current manual of survey instructions of the United States Department of the Interior, Bureau of Land Management or by a decree of a court of law. Furthermore, that the corner points mentioned in lines 3, 4 and 5 above were, in a field survey on _____, 19____, found, recovered, restored, established or re-established as expressed below and in conformance with the rules of the Michigan State Board of Registration for Land Surveyors or, by a Decree of a Court of law:

A. Description of original monument and accessories and/or subsequent restoration:


- B. Description of corner evidence found and/or method applied in restoring or re-establishing corner:
- J-9 Found iron bar as previously established in local surveys, at road intersection E-W-S.
 - K-8 Set corner relative to the found 1/8 and section corners south. This would conform to old 1919 curvey record although BT stumps are no longer evident.
 - 7 Set corner by standard survey procedure for the subdivision of sections.
 - 14 Found 1" iron bar at corner, which we conclude perpetuates old corner established in 1911 County survey.

C. Description of monument for corner and accessories established to perpetuate locating the position of the corner:

	J-9	K-8	
Fd 1 1/2" Iron Bar Raised w/1/2" pipe		Set DNR Monument	Set 5/8" Rod w/RRLS Cap
Nail in Power P	S46°E, 74.40'	5" Oak S89°E 19.8'	3" Maple S34°E 8.5'
Stop sign post	S78°W, 50.30'	7" Oak S14°E 48.8'	8" Maple in clump S20°W 36.7"
Red top post	N22°W, 29.0'		
			14
			Left 1" Iron Rod in place
			4" Maple S28°E 81.1'
			6" Maple S87° 77.7'

SIGNED BY Kenneth J. Ostling

DATE 10/20/80

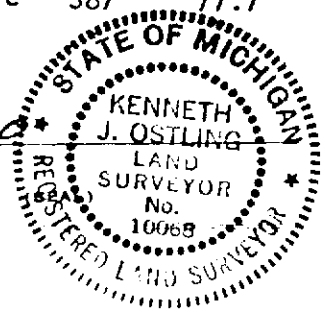

SURVEYOR'S MICHIGAN REGISTRATION NO. _____
FOR STATE AND UNITED STATES AGENCIES:

SIGNED BY _____ DATE _____
CHIEF OF SURVEY PARTY

APPROVED AND SIGNED BY _____ DATE _____
MICHIGAN REGISTERED LAND SURVEYOR

SURVEYOR'S MICHIGAN REGISTRATION NO. _____