

# LAND CORNER RECORDATION CERTIFICATE

## FILING REQUIREMENT OF ACT 74, MICH. P.A.1970

FOR CORNERS OF--:	LOCATED IN--:	CORNER CODE NUMBER
1. PUBLIC LAND SURVEY	T. 22 N. S., R. 6 W.	I-6; J-7; K-7
2. PROPERTY CONTROLLING IN SECTION 14	T. 22 N. S., R. 6 W.	10
3. MISCELLANEOUS PROPERTY IN SECTION	T. N. S., R. W.	
4. LOT NO. _____, RECORDED PLAT _____		
5. PRIVATE CLAIMS _____		

REGISTER OF DEEDS STAMP AND FILING NUMBER

I, Kenneth J. Ostling, do hereby certify that under requirements of P.A. 74, Michigan P.A. of 1970, the corner points mentioned in lines 1 and 2 above were, in a field survey on May 28, 1980, established, re-established, monumented, re-monumented, recovered or restored as expressed below and in conformance with regulations and rules therefore as required in the current manual of survey instructions of the United States Department of the Interior, Bureau of Land Management or by a decree of a court of law. Furthermore, that the corner points mentioned in lines 3, 4 and 5 above were, in a field survey on \_\_\_\_\_, 19\_\_\_\_, found, recovered, restored, established or re-established as expressed below and in conformance with the rules of the Michigan State Board of Registration for Land Surveyors or, by a Decree of a Court of law:

A. Description of original monument and accessories and/or subsequent restoration:

B. Description of corner evidence found and/or method applied in restoring or re-establishing corner:


- 1-6 Restored corner from 1911 NBTs of record, two pine stumps in place. Unable to locate corner post.
- J-7 Restored this corner at MPOL between section corners, as was indicated in 1911 survey of record. Does not exactly fit record NBT but felt this to be intent of previous survey. Could not find post bottom.
- K-7 Restored corner from 1911 NBTs of record, a pine stump showing notch and a large boulder in place. Unable to locate post.
- 10 Set by standard survey procedure for the subdivision of sections.

C. Description of monument for corner and accessories established to perpetuate locating the position of the corner:

I-6	J-7	K-7
Set DNR Monument	Set DNR Monument	Set DNR Mon from Old wit
3" W. Pine S25°W 38.2'	18" Oak N18°E, 13.1'	6" Oak S43°E 8.9'
8" Maple in clump S52°E, 28.3'	4" Maple N60°W 17.4'	5" Oak N37°E 10.4'
	24" WP Stump S50°W 12.4'	
	Old wit.	
		10
		Set 5/8 rod w/RLS Cap
		6" Maple N78°W 14.5'
		6" Oak S46°W 2.7'

SIGNED BY Kenneth Ostling  
 SURVEYOR'S MICHIGAN REGISTRATION NO. \_\_\_\_\_

DATE 10/28/80

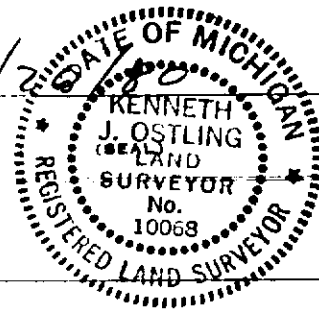

FOR STATE AND UNITED STATES AGENCIES:  
 SIGNED BY \_\_\_\_\_  
 CHIEF OF SURVEY PARTY

DATE \_\_\_\_\_

APPROVED AND SIGNED BY \_\_\_\_\_  
 MICHIGAN REGISTERED LAND SURVEYOR

DATE \_\_\_\_\_  
 (SEAL)

SURVEYOR'S MICHIGAN REGISTRATION NO. \_\_\_\_\_