

# LAND CORNER RECORDATION CERTIFICATE

## FILING REQUIREMENT OF ACT 74, MICH. P.A.1970

FOR CORNERS OF--:	LOCATED IN--:	CORNER CODE NUMBER
1. PUBLIC LAND SURVEY.....	T. 22 <span style="display: inline-block; width: 10px; height: 10px; background-color: black; border-radius: 50%; vertical-align: middle;"></span> N. R. 6 <span style="display: inline-block; width: 10px; height: 10px; background-color: black; border-radius: 50%; vertical-align: middle;"></span> W.	I-8; I-9
2. PROPERTY CONTROLLING IN SECTION <u>23</u>	T. 22 <span style="display: inline-block; width: 10px; height: 10px; background-color: black; border-radius: 50%; vertical-align: middle;"></span> N. R. 6 <span style="display: inline-block; width: 10px; height: 10px; background-color: black; border-radius: 50%; vertical-align: middle;"></span> W.	3; 10
3. MISCELLANEOUS PROPERTY IN SECTION.....	T. .... S. R. .... E. W.	
4. LOT NO. ...., RECORDED PLAT.....		
5. PRIVATE CLAIMS .....		

REGISTER OF DEEDS STAMP AND FILING NUMBER

I, Kenneth J. Ostling, do hereby certify that under requirements of P.A. 74, Michigan P.A. of 1970, the corner points mentioned in lines 1 and 2 above were, in a field survey on May 27, 1980, established, re-established, monumented, re-monumented, recovered or restored as expressed below and in conformance with regulations and rules therefore as required in the current manual of survey instructions of the United States Department of the Interior, Bureau of Land Management or by a decree of a court of law. Furthermore, that the corner points mentioned in lines 3, 4 and 5 above were, in a field survey on \_\_\_\_\_, 19\_\_\_\_, found, recovered, restored, established or re-established as expressed below and in conformance with the rules of the Michigan State Board of Registration for Land Surveyors or, by a Decree of a Court of law:

A. Description of original monument and accessories and/or subsequent restoration:


- B. Description of corner evidence found and/or method applied in restoring or re-establishing corner:
- I-8 Set by proportionate measurement between section corners. Unable to locate corner of record in 1911 survey.
  - I-9 Found corner as established in previous survey & used in more recent survey in this area.
  - 3 Set by standard survey procedure for the subdivision of sections.
  - 10 Set by standard survey procedure for the subdivision of sections.

C. Description of monument for corner and accessories established to perpetuate locating the position of the corner:

	I-8	I-9	3
Set DNR Monument		Fd. 1/2" bar; set DNR mon.	Set 5/8" Rod w/RLS Cap
6" Maple in clump		4" W. Pine S35°W 56.9	4" Maple N32°E 20.6
N39°E 19.4		4" Poplar S40°E 20.7	6" Maple N59°W 16.0
10" Maple in clump			
S22°E 28.6			
			10
			Set 5/8" rod w/RLS Cap
			6" Aspen S79°W 25.9
			11" Aspen N39°W 27.2

SIGNED BY Kenneth Ostling  
 SURVEYOR'S MICHIGAN REGISTRATION NO. 10068

DATE 9/4/80

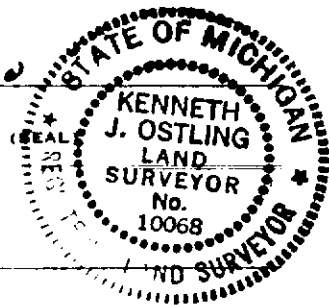

FOR STATE AND UNITED STATES AGENCIES:

SIGNED BY \_\_\_\_\_  
CHIEF OF SURVEY PARTY  
 APPROVED AND SIGNED BY \_\_\_\_\_  
MICHIGAN REGISTERED LAND SURVEYOR

DATE \_\_\_\_\_  
 (SEAL)

SURVEYOR'S MICHIGAN REGISTRATION NO. \_\_\_\_\_ MISSAUKEE COUNTY