

LAND CORNER RECORDATION CERTIFICATE

FILING REQUIREMENT OF ACT 74, MICH. P.A.1970

FOR CORNERS OF--:	LOCATED IN--:	CORNER CODE NUMBER
1. PUBLIC LAND SURVEY _____ T. _____	N. _____ E. _____ S., R. _____ W. _____	_____
2. PROPERTY CONTROLLING IN SECTION <u>13</u> , T. <u>22</u> , R. <u>6</u> W.	N. _____ E. _____ S., R. _____ W. _____	<u>16; 8; 4; 5</u>
3. MISCELLANEOUS PROPERTY IN SECTION _____ , T. _____	N. _____ E. _____ S., R. _____ W. _____	_____
4. LOT NO. _____ , RECORDED PLAT _____		
5. PRIVATE CLAIMS _____		

REGISTER OF DEEDS STAMP AND
FILING NUMBER

I, Kenneth J. Ostling, do hereby certify that under requirements of P.A. 74, Michigan P.A. of 1970, the corner points mentioned in lines 1 and 2 above were, in a field survey on August 14, 1980, established, re-established, monumented, re-monumented, recovered or restored as expressed below and in conformance with regulations and rules therefore as required in the current manual of survey instructions of the United States Department of the Interior, Bureau of Land Management or by a decree of a court of law. Furthermore, that the corner points mentioned in lines 3, 4 and 5 above were, in a field survey on _____, 19____, found, recovered, restored, established or re-established as expressed below and in conformance with the rules of the Michigan State Board of Registration for Land Surveyors or, by a Decree of a Court of law:

XX

C. Continued:

	5				16
Set 5/8" rod w/RLS cap					Set 5/8" rod w/RLS cap
6" Maple	S88°W	26.8'			6" Oak
5" Oak	S56°W	21.3'			7" Oak
					S51°W 8.9'
					N29°W 9.8'

B. Description of corner evidence found and/or method applied in restoring or re-establishing corner:


- 8 Set by standard survey procedure for the subdivision of sections.
- 4 Set by standard survey procedure for the subdivision of sections.
- 5 Set by standard survey procedure for the subdivision of sections.
- 16 Set by standard survey procedure for the subdivision of sections.

C. Description of monument for corner and accessories established to perpetuate locating the position of the corner:

	8				4
Set 5/8" rod w/RLS cap					Set 5/8" rod w/RLS cap
5" Oak	N33°E	11.5'			3" Maple
7" Oak	S60°E	7.6'			4" Maple
					S69°E 19.7'
					S58°W 4.9'

SIGNED BY Kenneth Ostling
 SURVEYOR'S MICHIGAN REGISTRATION NO. 10068

DATE 3-12-81

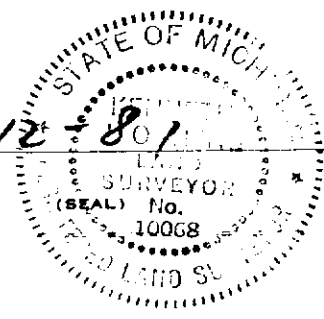

FOR STATE AND UNITED STATES AGENCIES:

SIGNED BY _____ DATE _____
CHIEF OF SURVEY PARTY
 APPROVED AND SIGNED BY _____ DATE _____
MICHIGAN REGISTERED LAND SURVEYOR

SURVEYOR'S MICHIGAN REGISTRATION NO. _____ **MISSAUKEE COUNTY**