

LAND CORNER RECORDATION CERTIFICATE
Filing Requirement of Act 74, Mich. P.A. 1970

1309

LIBER 315 PAGE 1111

MISSAUKEE COUNTY MICHIGAN

RECORDED DEC 29 1997 1:35 P.M.

Carolyn Florie
 REGISTER

Register of Deeds Stamp & File Number

For corners in _____
 (County)

Located In: _____ Corner Code # _____

1. Public Land Survey T 22N R 6W _____ M-5 _____
 T _____ R _____
 T _____ R _____
 T _____ R _____

2. Property Controlling S _____ T _____ R _____
 in Section S _____ T _____ R _____

3. Miscellaneous S _____ T _____ R _____
 Property in Sec. S _____ T _____ R _____

4. Lot No. _____, Recorded Plat _____

5. Private Claims _____

	A	B	C	D	E	F	G	H	I	J	K	L	M	
1														
2	6			5			4			3			2	1
3														
4	7			8			9			10			11	12
5														
6	18			17			16			15			14	13
7														
8	19			20			21			22			23	24
9														
10	30			29			28			27			26	25
11														
12	31			32			33			34			35	36
13														

I, Daniel E. Schripsema, in a field survey on October 1, 19 97 do hereby state that under requirements of P.A. 74, Michigan P.A. of 1970, the corner points mentioned in lines 1 and 2 above were in conformance with regulations and rules therefore as required in the current manual of survey instructions of the United States Department of the Interior, Bureau of Land Management or by a decree of a Court of Law and for that the corner points mentioned in lines 3, 4 and 5 above were in conformance with the rules of the Michigan Board of Land Surveyors or by a Decree of a Court of Law; established, re-established, monumented, recovered, found as expressed below:


NOTE: Not more than 2 corners, all in the same town and range, may be recorded on this certificate

- A. Description of original monument and accessories and/or subsequent restoration:
- M-5) 1837 John Brink GLO survey set post for sections 12 & 13; Beech 11 S42W 33, do 10 N31W 80
 1899 Richardson survey, cedar stake, bottle and stone, corner fence post 10 S33E 56
 1914 Beuthien survey, iron stake and stone
 1980 Ostling survey, DNR Plan No. R-57-C, found 5/8" iron
 1995 Daniel E. Schripsema survey
- B. Description of corner evidence found and/or method applied in restoring or reestablishing corner:
- M-5) Corner common to Sections 12 & 13, T22N, R6W and Section 7 & 8, T22N, R5W. Found 1/2" rebar 4' West of N & S road centerline an in centerline of E & W road.
 This corner is accepted as a careful and faithful perpetuation of the position of the original corner.
- C. Description of monument for corner and accessories established to perpetuate locating the position of the corner:
- M-5) Set Missaukee County Monument on existing 1/2" rebar
- | | | |
|------|---------|------------------------------|
| N41W | 45.73' | fence corner post - Fd. nail |
| N43E | 44.42' | grader blade |
| S82E | 178.38' | 24" maple |
| S65W | 80.22' | corner fence post |

Peer Group Reviewed and Approved
 Date: 12/18/97
 J. Dean Gaers, Missaukee Co. Representative

Signed by Daniel E. Schripsema Date 12-2-97

Surveyor's Michigan License No. 24617

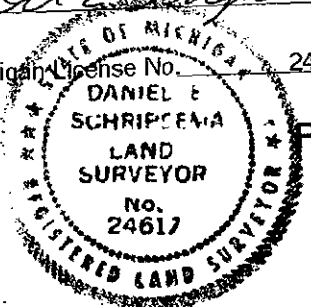

SURVEY & REMONUMENTATION

JAN 16 1998

SECTION

APPROVED BY MICHIGAN STATE BOARD OF PROFESSIONAL SURVEYORS, JAN. 28, 1971
 REVISED MAY 14, 1975
 REVISED JAN., 1985
 REVISED OCT., 1995