

SURVEY & REMONUMENTATION

APR 24 1995

LIBER 291 PAGE 436

983

LAND CORNER RECORDATION CERTIFICATE
Filing Requirement of Act 74, Mich. P.A. 1970

COMMISSION

For corners in

	<u>Missaukee</u> (County)	Located in:	Corner Code #
1. Public Land Survey		T 22N R 8W	M-5
		T _____ R _____	_____
		T _____ R _____	_____
		T _____ R _____	_____
2. Property Controlling in Section	S _____	T _____ R _____	_____
	S _____	T _____ R _____	_____
3. Miscellaneous Property in Sec.	S _____	T _____ R _____	_____
	S _____	T _____ R _____	_____

MISSAUKEE COUNTY MICHIGAN

RECORDED JAN 23 1995 12:01 PM

Paula Flare
REGISTER

Register of Deeds Stamp & File Number

4. Lot No. _____, Recorded Plat _____
5. Private Claims _____

	A	B	C	D	E	F	G	H	I	J	K	L	M
2	6		5		4		3		2		1		
3													
4	7		8		9		10		11		12		
5													
6	18		17		16		15		14		13		
7													
8	19		20		21		22		23		24		
9													
10	30		29		28		27		26		25		
11													
12	31		32		33		34		35		36		
13													

I, Daniel E. Schripsema, in a field survey on December, 19 94, do hereby certify that under requirements of P.A. 74, Michigan P.A. of 1970, the corner points mentioned in lines 1 and 2 above were in conformance with regulations and rules therefore as required in the current manual of survey instructions of the United States Department of the Interior, Bureau of Land Management or by a decree of a Court of Law and/or that the corner points mentioned in lines 3, 4 and 5 above were in conformance with the rules of the Michigan Board of Land Surveyors or by a Decree of a Court of Law; established, re-established, monumented, re-monumented, recovered, found as expressed below:

NOTE: Not more than 4 corners, all in the same town and range, may be recorded on this certificate.

A. Description of original monument and accessories and/or subsequent restoration:

- M-5) 1853 GLO post by John Brink, Deputy Surveyor
Hemlock 13 S 2 W 21, Hemlock 10 N 36 W 55
 - M-5) 1909 Missaukee County Survey Records, Field Book 2
Stake & 3 Stones
Tel. Pole N30 1/2E 71 1/2
Pine 40 N31W 84
- Cont' on back

B. Description of corner evidence found and/or method applied in restoring or reestablishing corner:

- M-5) Section corner common to Section 12, T22N, R8W and Section 13, T22N, R8W.
Found "T" iron in monument box per Liber 1, page 97 and is accepted as a careful and faithful perpetuation of the position of the original corner. Corner is located in the Centerline intersection of the North-South road and East-West road.

C. Description of monument for corner and accessories established to perpetuate locating the position of the corner:


- M-5) Set 1 1/2" Pipe with 2 1/2" brass Missaukee County monument over existing "T" Iron in monument box.

S 69 E 77.05 P.Pole
N 63 E 61.94 P.Pole
N 63 W 77.56 P.Pole
S 69 W 77.33 P.Pole

Peer Group Reviewed and Approved

Date: 11-2-94
J. Dear Geers
J. Dear Geers, Missaukee Co. Representative

Signed by Daniel E. Schripsema
Surveyor's Michigan License No. 24617

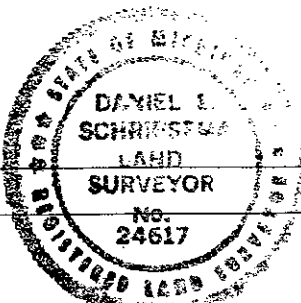

Date 12-30-94