

APR 24 1995

LIBER 291 PAGE 434

982

LAND CORNER RECORDATION CERTIFICATE
Filing Requirement of Act 74, Mich. P.A. 1970

COMMISSION
For corners in

_____	<u>Missaukee</u> (County)	Located In:	Corner Code #
1. Public Land Survey		T <u>22N</u> R <u>8W</u>	<u>M-6</u>
		T _____ R _____	_____
		T _____ R _____	_____
		T _____ R _____	_____
2. Property Controlling in Section	S _____ T _____ R _____	_____	_____
	S _____ T _____ R _____	_____	_____
3. Miscellaneous Property in Sec.	S _____ T _____ R _____	_____	_____
	S _____ T _____ R _____	_____	_____

MISSAUKEE COUNTY MICHIGAN
RECORDED ~~MAN~~ 23 1995 ^{12th} PM
Paulyn Flare
REGISTER
Register of Deeds Stamp & File Number

4. Lot No. _____, Recorded Plat _____
5. Private Claims _____

	A	B	C	D	E	F	G	H	I	J	K	L	M
2	6		5		4		3		2		1		
3													
4	7		8		9		10		11		12		
5													
6	18		17		16		15		14		13		
7													
8	19		20		21		22		23		24		
9													
10	30		29		28		27		26		25		
11													
12	31		32		33		34		35		36		
13													

I, Daniel E. Schripsema, in a field survey on December, 19 94, do hereby certify that under requirements of P.A. 74, Michigan P.A. of 1970, the corner points mentioned in lines 1 and 2 above were in conformance with regulations and rules therefore as required in the current manual of survey instructions of the United States Department of the Interior, Bureau of Land Management or by a decree of a Court of Law and/or that the corner points mentioned in lines 3, 4 and 5 above were in conformance with the rules of the Michigan Board of Land Surveyors or by a Decree of a Court of Law; established, re-established, monumented, re-monumented, recovered, found as expressed below:

NOTE: Not more than 4 corners, all in the same town and range, may be recorded on this certificate.

A. Description of original monument and accessories and/or subsequent restoration:

- M-6) 1853 GLO post by John Brink, Deputy Surveyor
Lynn 12 S 53 W 23, Birch 10 N 32 W 54
- M-6) 1909 Missaukee County Survey Records, Field Book 2
CedarStake & 3 Stones
Ironwood 6 N37E 72
Poplar 5 S25W 118
- M-6) 1973 J. Erickson survey, Liber S-1, page 75:
Corner was used but no witnesses given.
Cont' on back

B. Description of corner evidence found and/or method applied in restoring or reestablishing corner:

- M-6) Quarter Corner common to Section 13, T22N, R8W and Section 18, T21N, R7W

Found 1/2" iron rod per Liber 1, page 98 and is accepted as a careful and faithful reestablishment of the position of the original corner. Corner is located 13.8' West of the centerline of M-66.


C. Description of monument for corner and accessories established to perpetuate locating the position of the corner:

- M-6) Set 2 1/2" brass Missaukee County monument on existing iron and installed monument box.

- N 25 E 247.49 Power Pole
- S 69 E 102.85 Power Pole
- S 73 W 96.61 Power Pole
- N 87 W 86.19 1/2" capped iron
- S 15 W 97.27 NE cor. conc. headwall

Peer Group Reviewed and Approved
Date 11-2-94
J. Dean Gaers
Dean Gaers, Missaukee Co. Representative

Signed by Daniel E. Schripsema
Surveyor's Michigan License No. 24617

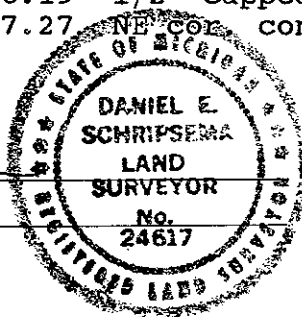

Date 12-30-94