

**SURVEY &
REMONUMENTATION**

LIBER 291 PAGE 432

APR 24 1995

LAND CORNER RECORDATION CERTIFICATE
Filing Requirement of Act 74, Mich. P.A. 1970

981

For corners in **COMMISSION**
Missaukee
(County)

Located In: Corner Code #

- | | | |
|------------------------------------|--------------------------|------------|
| 1. Public Land Survey | T <u>22N</u> R <u>8W</u> | <u>M-7</u> |
| | T _____ R _____ | _____ |
| | T _____ R _____ | _____ |
| | T _____ R _____ | _____ |
| 2. Property Controlling in Section | S _____ T _____ R _____ | _____ |
| | S _____ T _____ R _____ | _____ |
| 3. Miscellaneous Property in Sec. | S _____ T _____ R _____ | _____ |
| | S _____ T _____ R _____ | _____ |

MISSAUKEE COUNTY MICHIGAN

RECORDED JAN 23 1995 12:01 PM

Carolyn Flare
REGISTER

Register of Deeds Stamp & File Number

4. Lot No. _____, Recorded Plat _____
5. Private Claims _____

	A	B	C	D	E	F	G	H	I	J	K	L	M
2	6		5		4		3		2		1		
3													
4	7		8		9		10		11		12		
5													
6	16		17		16		15		14		13		
7													
8	19		20		21		22		23		24		
9													
10	30		29		28		27		26		25		
11													
12	31		32		33		34		35		36		
13													

I, Daniel E. Schripsema, in a field survey on December 19 94, do hereby certify that under requirements of P.A. 74, Michigan P.A. of 1970, the corner points mentioned in lines 1 and 2 above were in conformance with regulations and rules therefore as required in the current manual of survey instructions of the United States Department of the Interior, Bureau of Land Management or by a decree of a Court of Law and/or that the corner points mentioned in lines 3, 4 and 5 above were in conformance with the rules of the Michigan Board of Land Surveyors or by a Decree of a Court of Law; established, re-established, monumented, re-monumented, recovered, found as expressed below:

NOTE: Not more than 4 corners, all in the same town and range, may be recorded on this certificate.

A. Description of original monument and accessories and/or subsequent restoration:

- M-7) 1853 GLO post by John Brink, Deputy Surveyor
Hemlock 13 S 65 W 52,
Sugar 10 N 11 W 23
- M-7) Undated Missaukee County survey records Field Book 2
Large irregular stone + for corner.
Cont' on Back

B. Description of corner evidence found and/or method applied in restoring or reestablishing corner:

- M-7) Section corner common to Sections 13 and 24
Found 3/4" bar w/ 1 1/2" head per Liber 1, page 74 and accepted as a careful and faithful perpetuation of the position of the original corner.


C. Description of monument for corner and accessories established to perpetuate locating the position of the corner:

- M-7) Set Missaukee County monument on existing iron
- N 61 E 79.33 Tel. Ped. Pole
- S 52 E 49.88 P.Pole
- S 45 W 66.97 Tel. Ped. Pole
- N 56 W 66.34 Tel. Ped. Pole

Peer Group Reviewed and Approved

Date 11-2-94
J. Dean Giers
J. Dean Giers, Missaukee Co. Representative

Signed by Dale E. Schripsema
Surveyor's Michigan License No. 24617

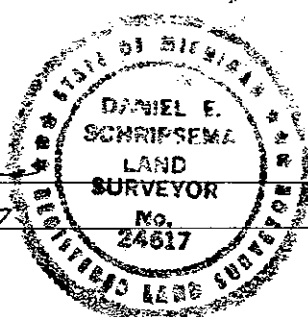

Date 12-30-94