

LAND CORNER RECORDATION CERTIFICATE

Filing Requirement of Act 74, Mich. PA 1970



For Corners In: Missaukee Located In _____ Corner Code # _____
(County)

1. Public Land Survey	T	<u>22N</u>	R	<u>8W</u>	<u>C11</u>
	T	_____	R	_____	_____
2. Property Controlling in Section	S	_____	T	_____	_____
	S	_____	T	_____	_____
3. Miscellaneous Property in Section	S	_____	T	_____	_____
	S	_____	T	_____	_____

4. Lot No: _____ Recorded Plat: _____
5. Private Claims: _____

I, Craig W. McVean, in a field survey on July 14, 2005 do hereby state that under requirements of PA 74, Michigan PA of 1970, the corner points mentioned in lines 1 and 2 above were in conformance with regulations and rules therefore as required in the current manual of survey instructions of the United States Department of the Interior, Bureau of Land Management or by a decree of a Court of Law and/or that the corner points mentioned in lines 3, 4 and 5 above were in conformance with the rules of the Michigan Board of Land Surveyors or by a Decree of a Court of Law; established, re-established, monumented, recovered, found as expressed below:

NOTE: Not more than 2 corners, all in the same town and range, may be recorded on this certificate.

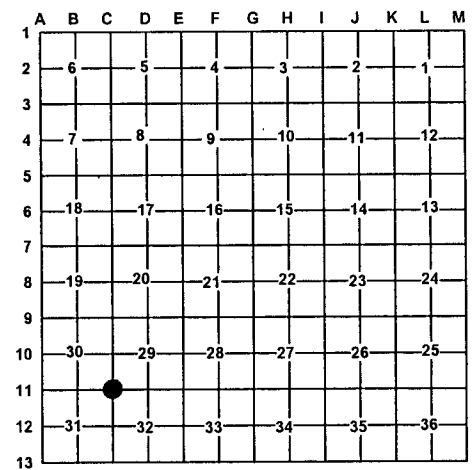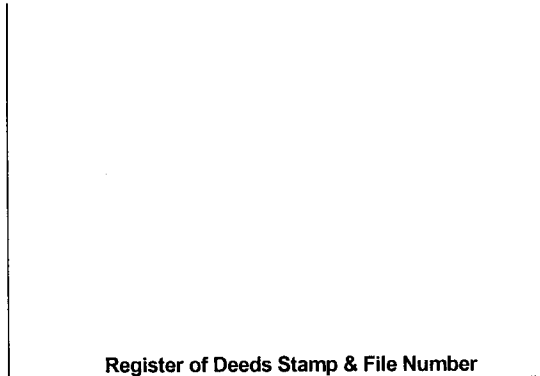

- A. Description of original monument and accessories and/or subsequent restoration:
- C11 – GLO – 1853 – W. L. Coffinberry – 24" Y. Pine
 N10¼°W 14 L. ; 24" Y. Pine S49°W 23 L.
 - CSR - 1906 – White Pine Stake - 38" W. Pine S06°E 74 L.
 - LCRC # 210 – 1967 – C.F. Roser – MDOT
 Job #00779A, Sheet 4 – Set 1 ¼" pipe from GLO stumps
 16" triple Maple N35°E 67.65'
 10" Maple S25°E 92.59'
 21" Oak S50°W 107.11'
 Y. Pine Stp. S50°W 15.77'
 Y. Pine remains N11°W 9'
 - Rec. Sur. – L. S – 1, p. 144 & LCRC # 162– 1974 –
 J. Wilcox – same wits as MSHD.
 - Rec. Sur. - L.315, p. 554 – Craig Pullen – 1997 –
 reference to LCRC - L. 152, p. 210 –
- Unrecorded survey -1999 - Philip Case –
 fd. 1 ½" pipe – 2" Oak S65°W 12.45'
 6" R. Pine N50° 7.16'
 8" Poplar S35° 12.15
 16" Poplar East 4.00
 - LCRC – L. 4, p. 1526, William E. Sikkema, 2002
 Fd. 1 ½" pipe of record. Fd. 38" W. Pine stump of CSR.
 Set Missaukee Co. Mon.
 East 4.00' - 16" Poplar
 N50°E 7.16' - 6" R. Pine
 S34°E 39.78' 3" R. Pine
 S46°W 33.60' - 3" Maple

- B. Description of corner evidence found and/or method applied in restoring or re-establishing corner:
- C11 – Section corner common to Sections 29, 30, 31 & 32, T22N, R8W - Found 1 ¼" I.D. iron pipe which fits witnesses of 2002 Remon. LCRC, two MDOT witnesses, and two Phillip Case witnesses, but no remon. cap on monument. 1 ¼" I.D. pipe is accepted as a careful and faithful perpetuation of the position of the original corner.

- C. Description of monument for corner and accessories established to perpetuate locating the position of the corner:
- C11 – Drove a stamped 2" Aluminum cap on 5/8" x 23" rebar inside Fd. 1 ¼" I.D. iron pipe.
 N03°E 32.73' to set N & T in W. side 3" Oak
 S36°E 39.92' to fd. nail in SW side 6" R. Pine (WES)
 S42°W 33.66' to fd. nail in SE side 4" R. Maple (WES)
 N50°E 7.16' to fd. nail in S. side 7" R. Pine (WES, PC)
 East 4.00' to fd. nail in S. side 18" Poplar (WES, PC)
 N35°E 67.69' to set N & T in SE side 14" triple Red Maple (MDOT)
 S52°W 107.06' to set N & T in SW side 36" Oak (MDOT)
 Set Blue Carsonite Post 1' NE



Signed by: Craig W. McVean
 Surveyor's Michigan License No.: 39088

Date: 5/11/2006