

# LAND CORNER RECORDATION CERTIFICATE

Filing Requirement of Act 74, Mich. PA 1970



For Corners In: \_\_\_\_\_ Located In \_\_\_\_\_ Corner Code # \_\_\_\_\_  
 Missaukee (County)

1. Public Land Survey	T _____	R _____	_____	_____
	T _____	R _____	_____	_____
2. Property Controlling in Section	S <u>29</u>	T <u>22N</u>	R <u>8W</u>	<u>8</u>
	S <u>29</u>	T <u>22N</u>	R <u>8W</u>	<u>15</u>
3. Miscellaneous Property in Section	S _____	T _____	R _____	_____
	S _____	T _____	R _____	_____

4. Lot No: \_\_\_\_\_ Recorded Plat: \_\_\_\_\_  
 5. Private Claims: \_\_\_\_\_

I, Craig W. McVean, in a field survey on July 20, 2005 do hereby state that under requirements of PA 74, Michigan PA of 1970, the corner points mentioned in lines 1 and 2 above were in conformance with regulations and rules therefore as required in the current manual of survey instructions of the United States Department of the Interior, Bureau of Land Management or by a decree of a Court of Law and/or that the corner points mentioned in lines 3, 4 and 5 above were in conformance with the rules of the Michigan Board of Land Surveyors or by a Decree of a Court of Law; established, re-established, monumented, recovered, found as expressed below:

**NOTE: Not more than 2 corners, all in the same town and range, may be recorded on this certificate.**

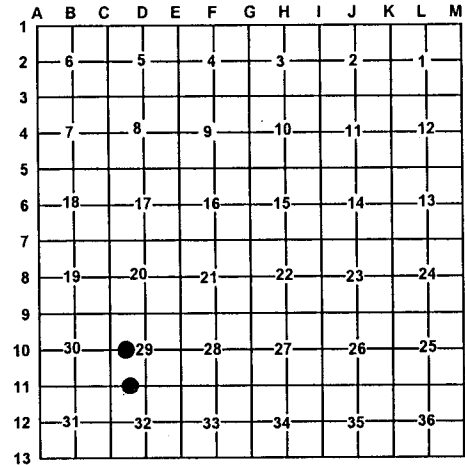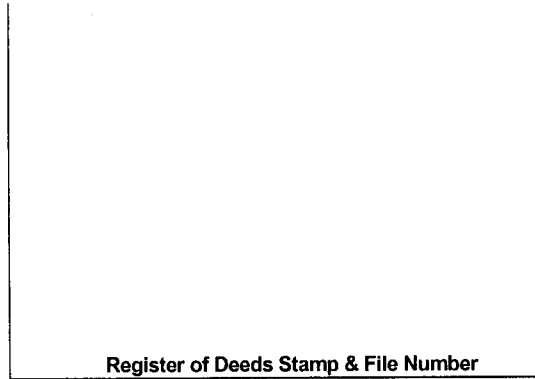

**A. Description of original monument and accessories and/or subsequent restoration:**

8 - Rec. Survey - L. S-3, p. 447, Craig J. Pullen - 1997  
 PS# 39095. Set 1/2" iron and cap.

15 - 1971 - C. F. Roser - MDOT - Job # 00779A, sheet 4  
 Set 3/4" x 2.3' pipe  
 S20°E 41.19' 18" WPS  
 S45°W 84.99' 30" Triple Oak

**B. Description of corner evidence found and/or method applied in restoring or re-establishing corner:**

8 - CW 1/16, Section 29, T22N, R8W - Found 1/2" x 18" capped iron PS #39095 per Rec. Survey. 1/2" CIR is accepted as best available evidence of the position of the corner.

15 - W 1/16, common to Sections 29 & 32, T22N, R8W - Found 3/4" pipe - up 0.3' per MDOT drawing. 3/4" pipe accepted as best available evidence of the position of the corner.

**C. Description of monument for corner and accessories established to perpetuate locating the position of the corner:**

8 - Replaced 1/2" x 18" capped iron with 2" stamped aluminum cap on 5/8" x 34" rebar.  
 S7°W 5.11' to set N & T in E. side triple 4" R. Maple  
 N62°W 19.82' to set N & T in NE side 3" W. Pine  
 N18°W 17.20' to set N & T in W. side 3" Oak  
 N62°E 37.94' to set N & T in SE side 6" W. Pine  
 Set Blue Carsonite Post with location tag 1' SE

15 - Drove 5/8" x 34" rebar into 3/4" pipe added 2" stamped aluminum cap.  
 S45°W 84.18' to set N & T in NW side 17" triple Oak (CFR)  
 S4°E 17.89' to set N & T in W. side 6" Oak  
 S82°E 14.36' to set N & T in N. side 4" Oak  
 N72°W 23.18' to set N & T in N. side 7" Cherry  
 Set Blue Carsonite Post w/Loc. tag 1' NW

Signed by: Craig W. McVean  
 Surveyor's Michigan License No.: 39088

Date: 5/11/2006

