

**LAND CORNER RECORDATION CERTIFICATE**  
**Filing Requirement of Act 74, Mich. P.A. 1970**

For corners in

# 1222

Missaukee County Located In: Corner Code #  
 (County)

1. Public Land Survey T 22N R 7W M-3  
 T R  
 T R  
 T R

2. Property Controlling S T R  
 in Section S T R

3. Miscellaneous S T R  
 Property in Sec. S T R

LIBER 315 PAGE 1125

MISSAUKEE COUNTY MICHIGAN  
 RECORDED DEC 29 1997 1:25 P.M.  
*Pauline Flare*  
 Register of Deeds Stamp & File Number

4. Lot No. \_\_\_\_\_, Recorded Plat \_\_\_\_\_  
 5. Private Claims \_\_\_\_\_

I, Daniel E. Schripsema, in a field survey on October 1, 1997 do hereby state that under requirements of P.A. 74, Michigan P.A. of 1970, the corner points mentioned in lines 1 and 2 above were in conformance with regulations and rules therefore as required in the current manual of survey instructions of the United States Department of the Interior, Bureau of Land Management or by a decree of a Court of Law and /or that the corner points mentioned in lines 3, 4 and 5 above were in conformance with the rules of the Michigan Board of Land Surveyors or by a Decree of a Court of Law; established, re-established, monumented, recovered, found as expressed below:

**NOTE: Not more than 2 corners, all in the same town and range, may be recorded on this certificate**

	A	B	C	D	E	F	G	H	I	J	K	L
1												
2	6			5		4		3		2		
3												
4	7			8		9		10		11		
5												
6	18			17		16		15		14		
7												
8	19			20		21		22		23		
9												
10	30			29		28		27		26		
11												
12	31			32		33		34		35		
13												

A. Description of original monument and accessories and/or subsequent restoration:

M-3) 1838 GLO survey set post sections 1, 12; White Pine 16 S15W 29, Sugar 10 N3 1/2W 29  
 1914 Beuthien survey, FB #34, pg. 56, county field notes; WPS 24 N37E 73, WPS 36 S48E 63

B. Description of corner evidence found and/or method applied in restoring or reestablishing corner:

M-3) Corner common to Sections 1 & 12, T22N, R7W and Sections 6 & 7, T22N, R6W. Set corner in center of trail road North with fences along trail road at 16.5' E. & W. and 9' South of center trail road East with fences along trail road 22' N. & S. This corner is accepted as the best available evidence of the position of the original corner.

C. Description of monument for corner and accessories established to perpetuate locating the position of the corner:


M-3) Set 3/4" x 36" rebar and Missaukee County Monument

S35W 27.68' 5" Elm  
 S24E 39.70' 5" Tamarack  
 N62W 78.30' 6" Spruce  
 N38E 72.96' 6" Spruce

Peer Group Reviewed and Approved

Date: 12-23-97  
*J. Dean Geers*  
 J. Dean Geers, Missaukee Co. Representative

Signed by \_\_\_\_\_ Date 12-2-97  
 Surveyor's Michigan License No. 24617

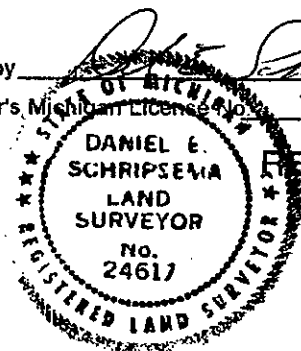

**SURVEY & MONUMENTATION**

JAN 16 1998

SECTION