

LAND CORNER RECORDATION CERTIFICATE
Filing Requirement of Act 74, Mich. P.A. 1970

For corners in

<u>Missaukee</u> (County)	Located In:	Corner Code #
1. Public Land Survey	T 22N R 7W	M-4
	T R	
	T R	
	T R	
2. Property Controlling in Section	S T R	
	S T R	
3. Miscellaneous Property in Sec.	S T R	
	S T R	
4. Lot No. _____, Recorded Plat _____		
5. Private Claims _____		

1204
 LIBER 315 PAGE 1106

MISSAUKEE COUNTY MICHIGAN
 RECORDED DEC 29 1997 ¹³⁵ 10 M.
Paulyn Flare
 REGISTER
 Register of Deeds Stamp & File
 Number

I, Daniel E. Schripsema, in a field survey on October 1, 19 97 do hereby state that under requirements of P.A. 74, Michigan P.A. of 1970, the corner points mentioned in lines 1 and 2 above were in conformance with regulations and rules therefore as required in the current manual of survey instructions of the United States Department of the Interior, Bureau of Land Management or by a decree of a Court of Law and for that the corner points mentioned in lines 3, 4 and 5 above were in conformance with the rules of the Michigan Board of Land Surveyors or by a Decree of a Court of Law; established, re-established, monumented, recovered, found as expressed below:

	A	B	C	D	E	F	G	H	I	J	K	L	M
1													
2	6		5		4		3		2		1		
3													
4	7		8		9		10		11		12		
5													
6	18		17		16		15		14		13		
7													
8	19		20		21		22		23		24		
9													
10	30		29		28		27		26		25		
11													
12	31		32		33		34		35		36		
13													

NOTE: Not more than 2 corners, all in the same town and range, may be recorded on this certificate

A. Description of original monument and accessories and/or subsequent restoration:

M-4) 1838 GLO set quarter post section 12; Tamarack 8 S41W 29, Spruce 7 N10W 25

B. Description of corner evidence found and/or method applied in restoring or reestablishing corner:

M-4) Corner common to Section 12, T22N, R7W and Section 7, T22N, R6W. Set 1/2" rebar with Missaukee County Monument by single proration along Township line between M-3 and M-6.

This corner is accepted as a careful and faithful reestablishment of the position of the original corner.

C. Description of monument for corner and accessories established to perpetuate locating the position of the corner:


M-4) Set Missaukee County Monument on existing iron

- S20W 7.60 3"W.Birch
- S32W 29.32 10"Tamarack
- S86E 28.75 10"Tamarack
- S42E 44.36 5"Tamarack

Peer Group Reviewed and Approved
 Date: 12-18-97
J. Dean Geers
 J. Dean Geers, Missaukee Co. Representative

Signed by *Daniel E. Schripsema* Date 12-2-97

Surveyor's Michigan License No. 24617

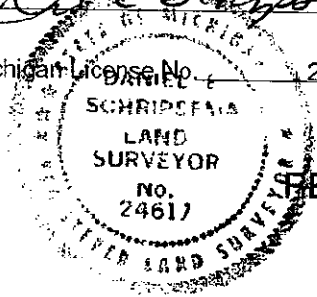

SURVEY & MONUMENTATION

JAN 16 1998

SECTION