

LAND CORNER RECORDATION CERTIFICATE
Filing Requirement of Act 74, Mich. P.A. 1970

For corners in

<u>Missaukee County</u> (County)	Located In:	Corner Code #
1. Public Land Survey	T <u>22N</u> R <u>7W</u>	<u>M-8</u>
	T ___ R ___	_____
	T ___ R ___	_____
	T ___ R ___	_____
2. Property Controlling in Section	S ___ T ___ R ___	_____
	S ___ T ___ R ___	_____
3. Miscellaneous Property in Sec.	S ___ T ___ R ___	_____
	S ___ T ___ R ___	_____
4. Lot No. _____, Recorded Plat _____		
5. Private Claims _____		

1225
LIBER 315 PAGE 112
 MISSAUKEE COUNTY MICHIGAN
 RECORDED DEC 29 1997 12:50 P.M.
Carolyn Klare
 REGISTER
 Register of Deeds Stamp & File
 Number

	A	B	C	D	E	F	G	H	I	J	K	L
1												
2	6			5			4			3		2
3												
4	7						8			9		10
5												11
6												
7												
8												
9												
10												
11												
12												
13												

I, Daniel E. Schripsema, in a field survey on October 1, 1997 do hereby state that under requirements of P.A. 74, Michigan P.A. of 1970, the corner points mentioned in lines 1 and 2 above were in conformance with regulations and rules therefore as required in the current manual of survey instructions of the United States Department of the Interior, Bureau of Land Management or by a decree of a Court of Law and /or that the corner points mentioned in lines 3, 4 and 5 above were in conformance with the rules of the Michigan Board of Land Surveyors or by a Decree of a Court of Law, established, re-established, monumented, recovered, found as expressed below:

NOTE: Not more than 2 corners, all in the same town and range, may be recorded on this certificate

- A. Description of original monument and accessories and/or subsequent restoration:
- M-8) 1837 GLO survey set quarter post section 24; Balsam 8 S66W 29, Cedar 10 N64W 19
 - 1898 Beuthien survey, FB #37, pg. 75, county surveyor notes; Gas Pipe 2 ft. long, 3/4" in diameter in place of stake
 - 1913 Beuthien survey, FB #35, pg. 68, county surveyor notes; Cedar Fence Post 10 N79W 37
 - 1976 Jerry L. Wilcox LCRC, #193; set 1/2" iron w/ cap, N89W 33.02, N80E Cor. Fe. Post 35.48
 - 1976 Jerry L. Wilcox survey, liber S-1, pg. 248; same as record LCRC #193
 - 1976 Jerry L. Wilcox survey, liber S-2, pg. 3
 - 1995 Craig J. Pullen survey, liber S-3, pg. 323; Fd. 1/2" iron & cap, S42E 8" Poplar 44.04, S89E Corner Fence Post 37.11, N38E 5" Elm 60.75


- B. Description of corner evidence found and/or method applied in restoring or reestablishing corner:
- M-8) Corner common to Section 24, T22N, R7W and Section 19, T22N, R6W. Found 1/2" rod / cap of record. This corner is accepted as a careful and faithful reestablishment of the position of the original corner

- C. Description of monument for corner and accessories established to perpetuate locating the position of the corner:
- M-8) Set Missaukee County Monument on existing 1/2" rod.
 - N89W 33.02' 1/2" iron / cap
 - S42E 44.04' 8" poplar
 - S89E 37.11' corner fence post
 - N38E 60.75' 5" elm

Peer Group Reviewed and Approved
 Date: 12-23-97
J. Dean Geers
 J. Dean Geers, Missaukee Co. Representative

Signed by *Daniel E. Schripsema*
 Surveyor's Michigan License No. 24617

Date 12-2-97

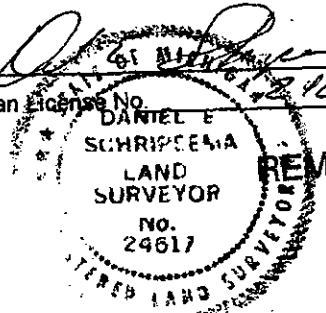

SURVEY & REMONUMENTATION
 FORM APPROVED BY MICHIGAN STATE BOARD OF PROFESSIONAL SURVEYORS, JAN. 28
 REVISED MAY 14
 REVISED JAN.
 REVISED OCT.
JAN 16 1998
SECTION