

LAND CORNER RECORDATION CERTIFICATE
Filing Requirement of Act 74, Mich. P.A. 1970

For corners in

<u>Missaukee County</u> (County)	Located In:	Corner Code #
1. Public Land Survey	T <u>22N</u> R <u>7W</u>	<u>M-12</u>
	T ___ R ___	___
	T ___ R ___	___
	T ___ R ___	___
2. Property Controlling in Section	S ___ T ___ R ___	___
	S ___ T ___ R ___	___
3. Miscellaneous Property in Sec.	S ___ T ___ R ___	___
	S ___ T ___ R ___	___
4. Lot No. _____, Recorded Plat _____		
5. Private Claims _____		

1229
LIBER 315 **PAGE** 1132

MISSAUKEE COUNTY MICHIGAN
RECORDED DEC 29 1997 ¹²⁵ P.M.
Carolyn Klare
Register of Deeds Stamp & File Number

I, Daniel E. Schripsema, in a field survey on October 1, 1997 do hereby state that under requirements of P.A. 74, Michigan P.A. of 1970, the corner points mentioned in lines 1 and 2 above were in conformance with regulations and rules therefore as required in the current manual of survey instructions of the United States Department of the Interior, Bureau of Land Management or by a decree of a Court of Law and /or that the corner points mentioned in lines 3, 4 and 5 above were in conformance with the rules of the Michigan Board of Land Surveyors or by a Decree of a Court of Law; established, re-established, monumented, recovered, found as expressed below:

	A	B	C	D	E	F	G	H	I	J	K	L	M
1													
2	6		5		4		3		2		1		
3													
4	7		8		9		10		11		12		
5													
6	18		17		16		15		14		13		
7													
8	19		20		21		22		23		24		
9													
10	30		29		28		27		26		25		
11													
12	31		32		33		34		35		36		
13													

NOTE: Not more than 2 corners, all in the same town and range, may be recorded on this certificate

A. Description of original monument and accessories and/or subsequent restoration:

- M-12) 1837 GLO survey, set quarter post Section 36 - Hemlock 10 S11W 24, Beech 7 N20W 2
- 1978 Jerry L. Wilcox LCRC no. 532, set R.R. Spike
- S40W 16" maple 65.31', S20E E.P.Pole 82.00', N45E E. Tel. Riser Box 46.29'
- 1981 Jerry L. Wilcox survey, rec. liber S2, pg. 68, ref. Liber 1, pg. 532
- 1982 Jerry L. Wilcox survey, rec. liber S2, pg. 118, same as rec. Liber 1, pg. 532

B. Description of corner evidence found and/or method applied in restoring or reestablishing corner:

- M-12) Corner common to Section 36, T22N, R7W, and Section 31, T22N, R6W. Found PK nail in centerline of N & S road and 1.5 South of E & W road. Corner is in agreement with surveys of record to North and South in Sec. 36 and fits conc. Mon. which is 33.00' South and West of Corner.

This corner is accepted as a careful and faithful reestablishment of the position of the original corner


C. Description of monument for corner and accessories established to perpetuate locating the position of the corner:

- M-12) Set Missaukee County Monument on 1/2" rerod
- N45E 46.14' post @ telephone riser (fd. bent nail)
- S25E 80.98' Power Pole (BM spike - bent)
- S55W 54.06' post @ telephone riser
- N77W 152.48' power pole

Peer Group Reviewed and Approved
Date: 12-23-97
J. Dean Geers
J. Dean Geers, Missaukee Co. Representative

Signed by _____ Date 12-2-97

Surveyor's Michigan License No. 24617

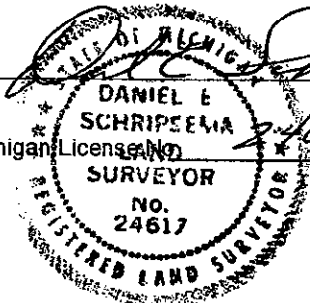

FORM APPROVED BY MICHIGAN STATE BOARD OF PROFESSIONAL SURVEYORS, JAN. 28, 19
REVISED MAY 14, 197
REVISED JAN., 19
REVISED OCT., 19

**SURVEY &
REMONUMENTATION**

JAN 16 1998

SECTION