

OCT 24 2000

SECTION

LAND CORNER RECORDATION CERTIFICATE
Filing Requirement of Act 74, Mich. P.A. 1970

#1113

For corners in

Missaukee County
(County)

Located In:

Corner Code #

LIBER 308 PAGE 906

- 1. Public Land Survey T 22N R 7W M-13
T ___ R ___
T ___ R ___
T ___ R ___
- 2. Property Controlling S ___ T ___ R ___
in Section S ___ T ___ R ___
- 3. Miscellaneous S ___ T ___ R ___
Property in Sec. S ___ T ___ R ___

MISSAUKEE COUNTY MICHIGAN

RECORDED DEC 30 1996 4:30 P.M.

Paula Flare
Register of Deeds Stamp & File
Number

- 4. Lot No. _____, Recorded Plat _____
- 5. Private Claims _____

I, Daniel E. Schripsema, in a field survey on October 1, 1996 do hereby state that under requirements of P.A. 74, Michigan P.A. of 1970, the corner points mentioned in lines 1 and 2 above were in conformance with regulations and rules therefore as required in the current manual of survey instructions of the United States Department of the Interior, Bureau of Land Management or by a decree of a Court of Law and for that the corner points mentioned in lines 3, 4 and 5 above were in conformance with the rules of the Michigan Board of Land Surveyors or by a Decree of a Court of Law, established, re-established, monumented, recovered, found as expressed below:

	A	B	C	D	E	F	G	H	I	J	K	L	M
1													
2	6			5		4		3		2			1
3													
4	7			8		9		10		11			12
5													
6	18			17		16		15		14			13
7													
8	19			20		21		22		23			24
9													
10	30			29		28		27		26			25
11													
12	31			32		33		34		35			36
13													

NOTE: Not more than 2 corners, all in the same town and range, may be recorded on this certificate

A. Description of original monument and accessories and/or subsequent restoration:

- M-13) 1837 GLO survey John Brink, Deputy Surveyor, set post - Beech 8" N46E 44, W. Pine 12" N57W 17
1892 & 1910 Beuthien County Surveyor notes pg. 55, cedar post & crockery - cedar f. post N41 1/2 E 56, maple tree 4" S47 1/2 W
1894 County Surveyor notes pg. 73, cedar stake with crockery
1910 County Surveyor notes pg. 75, cedar stake with crockery with large stone on top of post
County Surveyor notes pg. 93, Twin poplars 14" S.W. 62.5', F.P. S.E. 50.5', F.P. S.W. 44', Marker N.W. 43'
1977 Jerry L. Wilcox LCRC no. 528, Found 3/4" iron pipe (E. A. Beuthien survey of record, Oct. 6, 1910) - S47W 30" maple 62.06', S68W 50" cottonwood 63.62', N41W power pole 138.09', S80E 3/4" iron pipe 4.49'
1981 Jerry L. Wilcox survey, rec. liber S2, pg. 68, fd. 3/4" pipe

B. Description of corner evidence found and/or method applied in restoring or reestablishing corner:

- M-13) Section corner common to Sec. 36, T22N, R7W, Sec. 1, T21N, R7W, Sec. 31, T22N, T6W, and Sec. 6, T21N, R6W, Found 3/4" pipe of record. 1.75 W. of centerline N&S road, centerline of road West, and 2.5' N. of centerline of road East, corner is 16" deep below surface. This corner is accepted as a careful and faithful perpetuation of the position of the original corner.

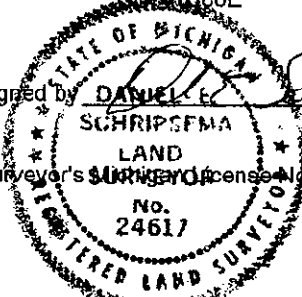
Note: Found 3/4" iron pipe bearing S80E 4.49' was left in place as decided by peer group

C. Description of monument for corner and accessories established to perpetuate locating the position of the corner:

- M-13) Placed Miss. Co. Remonumentation Cap on existing 3/4" pipe and added mon. box
- S51W 61.87' 34" maple (fd. Nail)
- S70W 63.28' 50" cottonwood (fd. Nail)
- N34W 138.18' power pole (fd. Nail)
- N60E 175.79' power pole (fd. Nail)
- S80E 4.49' 3/4" pipe

Peer Group Reviewed and Approved

Date: 12-30-96
J. Deap Geers
J. Deap Geers, Missaukee Co. Representative

Signed by Daniel E. Schripsema

 Surveyor's License No. 24617

Date 12-30-96