

MICHIGAN
DEPARTMENT OF CONSERVATION
FORESTRY DIVISION

LAND CORNER RECORD


T. 23 N.R. 5 W
T. 24 N.R. 5 W
Missaukee COUNTY

DESCRIPTION OF CORNER 1/4 corner common to Sections 4-33

CORNER MONUMENT Set 1" pipe with 4" aluminum cap below surface

DATE MONUMENT PLACED AND WITNESSED 5-9-67

WITNESSES TO CORNER.....

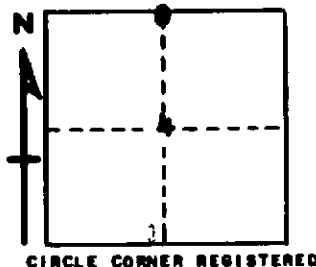

10" Maple N 36 W 50.6'

18" Tw. R. Oak N 73 E 82.5'

AND

DESCRIPTION IN DETAIL AS TO HOW CORNER WAS LOCATED AND IDENTIFIED OR RESTORED.

This corner was found during a survey in this township. Found 3/4" pipe in line with roads west and south, and about 3' south of fence line east. One possible USBT stump in place. Best available evidence.

SURVEYOR'S SEAL

SIGNED _____ DATE 5-25-67
REGISTERED LAND SURVEYOR #10068