

MICHIGAN
DEPARTMENT OF CONSERVATION
FORESTRY DIVISION



LAND CORNER RECORD

T. 23 N.R. 5 W


Missaukee COUNTY

DESCRIPTION OF CORNER Sec. corner common to Sections 3-4-9-10

CORNER MONUMENT Set 1" pipe with/Alum. cap

DATE MONUMENT PLACED AND WITNESSED 5-12-67

WITNESSES TO CORNER.....

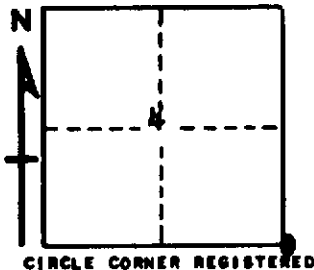

6" S. Maple N 49 E 20.2'

8" R. Oak S 39 W 35.8'

AND

DESCRIPTION IN DETAIL AS TO HOW CORNER WAS LOCATED AND IDENTIFIED OR RESTORED.

This corner was found during a survey in this township. Found 1 1/2" pipe with concrete base at corner, as established in previous survey by Marcus Schaaf, R.L.S. Falls at fence corner and checks good with original 1/4 corner North.

SURVEYOR'S SEAL

SIGNED _____ DATE 6-7-67
REGISTERED LAND SURVEYOR #10068