LAND CORNER RECORDATION CERTIFICATE

Filing Requirement of Act 74, Mich. P.A. 1970

For corners in

MISSAUKEE (County)

		Located In:		Corner Code
1. Public Land Survey		T 23N	R 05W	I-3
		T	R	
		T	R	
		T	R	
2. Property Controlling	S 10	T 23N	R 05W	2, 6
in Section	S	T	R	
3. Miscellaneous	S 10	T 23N	R 05W	⁜657.3' N OF #9
Property in Sec.	S	T	R	

Register of Deeds Stamp & File Number

4. Lot No. , Recorded Plat
5. Private Claims

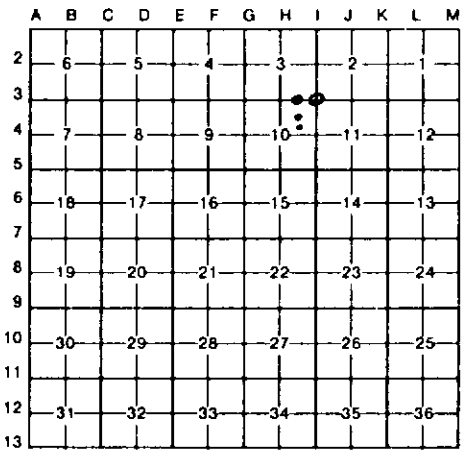

I, CARL F. ROSER, in a field survey on APRIL 15, 19 86, do hereby certify that under requirements of P.A. 74, Michigan P.A. of 1970, the corner points mentioned in lines 1 and 2 above were in conformance with regulations and rules therefore as required in the current manual of survey instructions of the United States Department of the Interior, Bureau of Land Management or by a decree of a Court of Law and/or that the corner points mentioned in lines 3, 4 and 5 above were in conformance with the rules of the Michigan Board of Land Surveyors or by a Decree of a Court of Law; established, re-established, monumented, re-monumented, recovered, found as expressed below:

NOTE: Not more than 4 corners, all in the same town and range, may be recorded on this certificate.

C. (CONTINUED)

XXXXXXXXXXXXXXXXXXXXXXXXXXXXXXXX and accessories and/or subsequent restoration:

⁜

DROVE 5/8" X 17" REROD W/RLS CAP.		
6" MAPLE	S55°E	39.42
32" R OAK	N75°W	50.38
DROVE 5/8" X 34" REROD W/RLS		
CAP & SET CED POST W/LOC TAG.	N88°04'W	33.00
CTR N-S ROAD	WEST	4'

STATE OF MICHIGAN
CARL F. ROSER
LAND SURVEYOR
No. 12028
REGISTERED LAND SURVEYOR

B. Description of corner evidence found and/or method applied in restoring or reestablishing corner:

I-3 PREVIOUS DEPT COR OF RECORD (K.J.O.-1967). K.J.O. FD 1/2" PIPE W/U.S. B.T. NE IN PLACE AS REMARKED BY E.A.BEUTHIEN IN SEPT 1914.

2 FD & ACCEPTED 1/2" X 24" IR ROD W/RLS CAP. FITS E.A. BEUTHIEN 1914 W.P.S.,N55E, 54.8'-REC. (55.2'-MEA.). FD 3' LONG OLD RUSTY WELL POINT (WIGGLY, APPROX 1' IN GRD). S89°21'W, 21.95'.

6 ESTAB CTR OF NE 1/4 OF SEC 10 PER STANDARD BLM INSTRUCTIONS.

⁜ DROVE 5/8" X 17" REROD AT SE COR OF S 1/2 - N1/2 - SW 1/4 - NE 1/4 OF SEC 10. CTR OF TRAIL ROAD WESTERLY ACROSS STATE LAND IS NORTH 110'±.

C. Description of monument for corner and accessories established to perpetuate locating the position of the corner:

I-3			2			6		
FD DEPT MON & CED POST.			FD 1/2" X 24" IR ROD			DROVE 5/8" X 17" REROD		
3" MAPLE	N78°E	11.2'	W/RLS CAP.			W/RLS CAP.		
9" MAPLE	N36°W	29.2'	4" MAPLE	S35°E	46.04	PINE POLE	S85°W	36.63
18" R PINE STP	SOUTH	23.9'	8" MAPLE	N65°E	45.43	6" MAPLE	N65°E	59.94
24" W PINE STP	N04°W	21.5'	4" R OAK	S80°E	32.70	5" OAK	S50°E	36.89
18" R PINE	S26°E	24.8'	SET CED POST			SET CED POST		
			W/LOC TAG.	EAST	33'	W/LOC TAG.	EAST	33'
			CTR N-S RD	EAST	3'	CTR N-S RD.	WEST	3'

Signed by Carl F. Roser 05-06-86 Date

Surveyor's Michigan License No. 12028

FORM APPROVED BY MICHIGAN STATE BOARD OF LAND SURVEYORS, JAN. 28, 1971
REVISED MAY 14, 1975
REVISED JAN., 1983