

LAND CORNER RECORDATION CERTIFICATE
Filing Requirement of Act 74, Mich. P.A. 1970

For corners in

<u>Missaukee</u> <small>(County)</small>	Located In:	Corner Code #
1. Public Land Survey	T 23N R 5W	I - 8
	T _____ R _____	_____
	T _____ R _____	_____
2. Property Controlling in Section	S _____ T _____ R _____	_____
	S _____ T _____ R _____	_____
3. Miscellaneous Property in Sec.	S _____ T _____ R _____	_____
	S _____ T _____ R _____	_____

4. Lot No. _____, Recorded Plat _____

5. Private Claims _____

Register of Deeds Stamp & File Num

I, Craig W. McVean, in a field survey on February 20 19 97 do hereby state that under requirements of P.A. 74, Michigan P.A. of 1970, the corner points mentioned in lines 1 and 2 above were in conformance with regulations and rules therefore as required in the current manual of survey instructions of the United States Department of the Interior, Bureau of Land Management or by a decree of a Court of Law and /or that the corner points mentioned in lines 3, 4 and 5 above were in conformance with the rules of the Michigan Board of Land Surveyors or by a Decree of a Court of Law; established, re-established, monumented, recovered, found as expressed below:

NOTE: Not more than 2 corners, all in the same town and range, may be recorded on this certificate.

A	B	C	D	E	F	G	H	I	J	K	L	M
1												
2	6		5		4		3		2		1	
3												
4	7		8		9		10		11		12	
5												
6	18		17		16		15		14		13	
7												
8	19		20		21		22	●	23		24	
9												
10	30		29		28		27		26		25	
11												
12	31		32		33		34		35		36	
13												

A. Description of original monument and accessories and/or subsequent restoration:


- I-8 - GLO - Set 1/4 Post - A. Curtis - 1852
Spruce 6" N38°E 5L
Tamarack 7" S63°W 16L
- Co. Surveyor Notes - Book 23, Page 60 - states "Stake and Iron - Tam 7" N09°E 28L"-J. McBain-No date

B. Description of corner evidence found and/or method applied in restoring or reestablishing corner:

- I-8 - 1/4 Cor. common to Sec. 22 & 23-Found 4" wide X 1/4" X 35" long Iron Sleigh runner upright in swamp by projecting the fence line remains South from North. Fence remains also go East.
Also found 1" X 4" of rotten wood stake where runner was found.
Monument accepted as the best available evidence of the position of the original corner.

C. Description of monument for corner and accessories established to perpetuate locating the position of the corner:

- I-8 - Replaced Sleigh runner with 1" X 118" long galv. Iron Pipe with 4" Aluminum DNR Cap.
Left pipe 2' above swamp. Placed sleigh runner at N edge of Pipe as memorial.
S89°E 36.15' to set nail and tag in S side old 7" Cedar fence post in old E-W fence remains
S28°E 302.79' to set nail and tag in W side 13" Tamarack
S07°W 329.63' to set nail and tag in E side 13" B.Cherry (just south of willow-alder swamp)
Set blue carsonite guard post

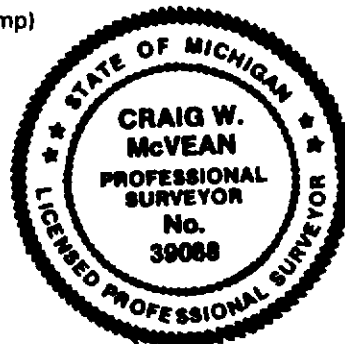

Signed by Craig W. McVean
 Surveyor's Michigan License No. 39088

Date 3/6/1998