

JAN 27 1999

LAND CORNER RECORDATION CERTIFICATE
Filing Requirement of Act 74, Mich. P.A. 1970

#1248

LIBER 318 PAGE 137

SECTION
For corners in

Missaukee (County)	Located In:	Corner Code #
1. Public Land Survey	T 23N R 5W T _____ R _____	F11
2. Property Controlling in Section	S _____ T _____ R _____ S _____ T _____ R _____	_____
3. Miscellaneous Property in Sec.	S _____ T _____ R _____ S _____ T _____ R _____	_____

MISSAUKEE COUNTY MICHIGAN

RECORDED APR. 9 1998 2:15 P.M.

Caryn Flor
REGISTER
Register of Deeds Stamp & File Num.

4. Lot No. _____, Recorded Plat _____

5. Private Claims _____

I, Craig W. McVean, in a field survey on March 12 1997 do hereby state that under requirements of P.A. 74, Michigan P.A. of 1970, the corner points mentioned in lines 1 and 2 above were in conformance with regulations and rules therefore as required in the current manual of survey instructions of the United States Department of the Interior, Bureau of Land Management or by a decree of a Court of Law and /or that the corner points mentioned in lines 3, 4 and 5 above were in conformance with the rules of the Michigan Board of Land Surveyors or by a Decree of a Court of Law; established, re-established, monumented, recovered, found as expressed below:

	A	B	C	D	E	F	G	H	I	J	K	L	M
1													
2	6		5		4		3		2		1		
3													
4	7		8		9		10		11		12		
5													
6	13		17		16		15		14		13		
7													
8	19		20		21		22		23		24		
9													
10	30		29		28		27		26		25		
11													
12	31		32		33		34		35		36		
13													

NOTE: Not more than 2 corners, all in the same town and range, may be recorded on this certificate.

A. Description of original monument and accessories and/or subsequent restoration:

F11- GLO-Set 1/4 post-A. Curtis-1852
Hemlock 10" S80°W 30L.
Beech 8" N40°E 40L.
-Miss. Co. Bk. 24, P. 66 & Bk. 21, P. 64 & 72- Fnd. Stp's of
OBT's. Set new post-1915- NBT- WPS 36" S78°E 81L,
WPS 40" N43°W 102L., W. Pine 7" N78.5°W 307L.- Dist. S
W & E

B. Description of corner evidence found and/or method applied in restoring or reestablishing corner:


F11- 1/4 cor. common to Sec. 28 & 33- Set 4" DNR A.C. on 1"x
6' long galv. iron pipe from two Old NBT's as referenced in County
Notes. Also find depression in ground at location for SE O-NBT.
Monument fits Co. dist. S. to F13 within 2' +/- and dist. E. to
G11 within 1' +/- . Fence N-S is 31' E. and fence E-W is 138' N.
Monument accept as a careful and faithful perpetuation of the
position of the original corner.

C. Description of monument for corner and accessories established to perpetuate locating the position of the corner:

F11- 4" DNR A.C. on 1"x 6' long iron pipe-Set Carsonite post 1'N
N41°W 69.00' to 2" A.C. on 5/8" x34" rebar in the CL.
remains of 40" W. Pine Stp. (O-NBT)
N81°W 202.80' to S&T in S. side 24" W. Pine (O-NBT)
N10°E 142' to Fen. Cor.-E,W,S
N58°E 37.37' to N&T in NW side 5" Wood Fen. Post
S63°W 127.31' to N&T in N side 2" Twin Thornapple

Peer Group Reviewed and Approved

Date: 4-8-98
J. Dean Geers
J. Dean Geers, Missaukee Co. Representative

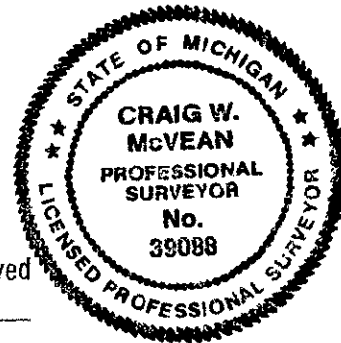

Signed by Craig W. McVean
Surveyor's Michigan License No. 39088

Date 3/6/1998