

JAN 27 1999

LAND CORNER RECORDATION CERTIFICATE
Filing Requirement of Act 74, Mich. P.A. 1970

#1250

SECTION


For corners in

<u>Missaukee</u> <small>(County)</small>	Located In:	Corner Code #
1. Public Land Survey	T <u>23N</u> R <u>5W</u>	<u>G12</u>
	T _____ R _____	_____
2. Property Controlling in Section	S _____ T _____ R _____	_____
	S _____ T _____ R _____	_____
3. Miscellaneous Property in Sec.	S _____ T _____ R _____	_____
	S _____ T _____ R _____	_____
4. Lot No. _____, Recorded Plat _____		
5. Private Claims _____		

LIBER 318 PAGE 139
MISSAUKEE COUNTY MICHIGAN
RECORDED APR. 9 1998 ^{2:15} P.M.
Rosalyn Flare
REGISTER
Register of Deeds Stamp & File Num

I, Craig W. McVean, in a field survey on January 21 1997 do hereby state that under requirements of P.A. 74, Michigan P.A. of 1970, the corner points mentioned in lines 1 and 2 above were in conformance with regulations and rules therefore as required in the current manual of survey instructions of the United States Department of the Interior, Bureau of Land Management or by a decree of a Court of Law and /or that the corner points mentioned in lines 3, 4 and 5 above were in conformance with the rules of the Michigan Board of Land Surveyors or by a Decree of a Court of Law; established, re-established, monumented, recovered, found as expressed below:

NOTE: Not more than 2 corners, all in the same town and range, may be recorded on this certificate.

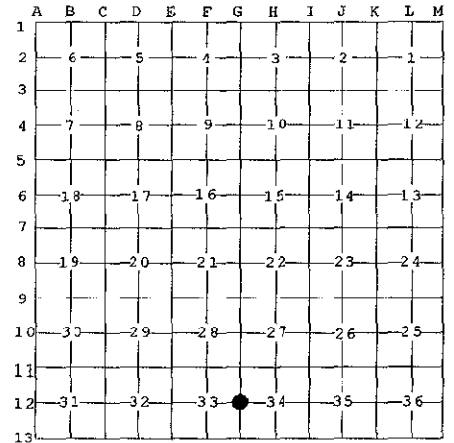

A. Description of original monument and accessories and/or subsequent restoration:

G12- GLO- Set 1/4 post -A. Curtis- 1852
Elm 7" N22°E 11L.
Elm 5" S46°W 11L.
-Miss. Co. Bk. 24, P. 63 & Bk. 21, P. 60- Set new post in swamp (wet)-1915- Elm 10" S60°E 72L.

B. Description of corner evidence found and/or method applied in restoring or reestablishing corner:

G12- 1/4 Cor. common to Sec. 33 & 34- Excavate 10' X 10' area in swamp at extension of fences from E & S. Find very rotten wood post with wire lying in swamp and then post bottom driven into clay with some cobble stones around. Many pieces of wood post in this area 1-6" dia. up 1.5' long. Position fits Co. distances E & S. Monument accepted as the best available evidence of the position of the original corner.

C. Description of monument for corner and accessories established to perpetuate locating the position of the corner:

G12- Set 4" DNR A.C. on 1"x4' long galv. iron pipe at post bottom position. Place wood post remains and cobbles around.
Set orange Carsonite guard post 1' N
N28°E 44.75' to N&T in NW side 4" Ash scribed "XBT"
N61°E 42.66' to N&T in N side 8" Elm scribed "XBT"
S25°W 27.74' to N&T in NW side 5" R. Maple scribed "XBT"
S87°W 65.05' to N&T in S side 17" R. Maple scribed "XBT"
N50°W 43.58' to N&T in SW side 8" R. Maple scribed "XBT"

Signed by Craig W. McVean
Surveyor's Michigan License No. 39088

Date 3/6/1998