

**LAND CORNER RECORDATION CERTIFICATE**  
**Filing Requirement of Act 74, Mich. P.A. 1970**

#1276

For corners in

<u>Missaukee</u> (County)	Located In:	Corner Code #
1. Public Land Survey	T 23N R 5W	L11
	T _____ R _____	_____
2. Property Controlling in Section	S _____ T _____ R _____	_____
	S _____ T _____ R _____	_____
3. Miscellaneous Property in Sec.	S _____ T _____ R _____	_____
	S _____ T _____ R _____	_____

LIBER 318 PAGE 159

MISSAUKEE COUNTY MICHIGAN

RECORDED APR. 9 1998 <sup>3:15</sup> PM

*Caryn Flare*  
REGISTERED

Register of Deeds Stamp & File Num

4. Lot No. \_\_\_\_\_, Recorded Plat \_\_\_\_\_

5. Private Claims \_\_\_\_\_

I, Craig W. McVean, in a field survey on March 4 1997 do hereby state that under requirements of P.A. 74, Michigan P.A. of 1970, the corner points mentioned in lines 1 and 2 above were in conformance with regulations and rules therefore as required in the current manual of survey instructions of the United States Department of the Interior, Bureau of Land Management or by a decree of a Court of Law and for that the corner points mentioned in lines 3, 4 and 5 above were in conformance with the rules of the Michigan Board of Land Surveyors or by a Decree of a Court of Law; established, re-established, monumented, recovered, found as expressed below:

**NOTE: Not more than 2 corners, all in the same town and range, may be recorded on this certificate.**

A	B	C	D	E	F	G	H	I	J	K	L	M
1												
2	6	5	4	3	2	1						
3												
4	7	8	9	10	11	12						
5												
6	18	17	16	15	14	13						
7												
8	19	20	21	22	23	24						
9												
10	30	29	28	27	26	25						
11												
12	31	32	33	34	35	36						
13												

A. Description of original monument and accessories and/or subsequent restoration:

L11-GLO-Set 1/4 post- A. Curtis-1852  
 Spruce 10" N65°E 37L.  
 Spruce 5" S55°W 17L.

SURVEY &  
RE-MONUMENTATION

JAN 27 1999

SECTION

B. Description of corner evidence found and/or method applied in restoring or reestablishing corner:

L11- 1/4 cor. common to Sec. 25 & 36-No evidence fnd.- Set 4"  
 DNR A.C. on 1"X3' long galv. iron pipe by single proportion  
 between K11 & M11. Measure 310' +/-30'(322'-GLO) to edge of  
 J. pine (spruce-GLO) swamp. Monument accepted at a careful and  
 faithful re-establishment of the position of the original corner.


C. Description of monument for corner and accessories established to perpetuate locating the position of the corner:

L11-4"A.C. on 1" pipe-set carsonite guard post 1' NNE  
 S61°W 45.04' to N & T in N Side 12" R. Pine scribed "XBT"  
 N 3°E 21.94' to N & T in W Side 7" R. Pine scribed "XBT"  
 East 79.19' to N & T in N Side 9" Twin R. Pine scribed "XBT"  
 S30°E 80.65' to N & T in E Side 9" R. Pine scribed "XBT"

Peer Group Reviewed and Approved

Date: 4/8/98

J. Dean Geers, Missaukee Co. Representative

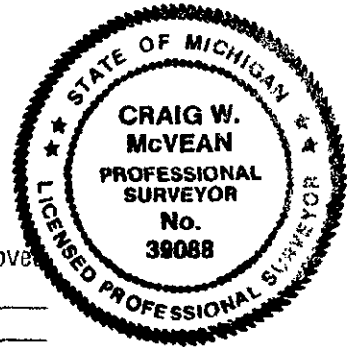

Signed by Craig W. McVean

Date 3/6/1998

Surveyor's Michigan License No. 39088