LAND CORNER RECORDATION CERTIFICATE

Filing Requirement of Act 74, Mich. P.A. 1970

For corners in
MISSAUKEE
(County)

	Located In:	Corner Code #
1. Public Land Survey	T 23N R 6W	I-1, K-1
	T ___ R ___	K-2
	T ___ R ___	
	T ___ R ___	
2. Property Controlling	S 3 T ___ R ___	7
in Section	S ___ T ___ R ___	
3. Miscellaneous	S ___ T ___ R ___	
Property in Sec.	S ___ T ___ R ___	

Register of Deeds Stamp & File Number

4. Lot No. _____ , Recorded Plat _____
5. Private Claims _____

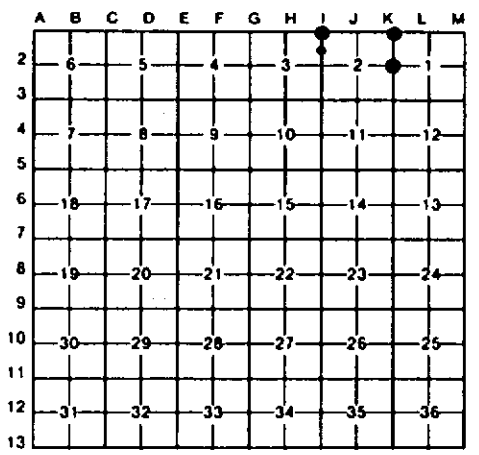

I, CARL F. ROSER, in a field survey on SEPTEMBER 26, 19 89, do hereby certify that under requirements of P.A. 74, Michigan P.A. of 1970, the corner points mentioned in lines 1 and 2 above were in conformance with regulations and rules therefore as required in the current manual of survey instructions of the United States Department of the Interior, Bureau of Land Management or by a decree of a Court of Law and/or that the corner points mentioned in lines 3, 4 and 5 above were in conformance with the rules of the Michigan Board of Land Surveyors or by a Decree of a Court of Law; established, re-established, monumented, re-monumented, recovered, found as expressed below:

NOTE: Not more than 4 corners, all in the same town and range, may be recorded on this certificate.

A. Description of original monument and accessories and/or subsequent restoration:

I-1 K-1 K-2 7

B. Description of corner evidence found and/or method applied in restoring or reestablishing corner:

I-1
REESTABLISHED NE COR SEC 3 MIDWAY & ON LINE BETWEEN SEC CORNERS 1 MILE E & W. CTR OF N-S TRAIL IS 16' WEST.

K-1
RESTORED SEC COR COMM TO SEC'S 1 & 2 (T23N-R6W) AND SEC'S 35 & 36 (T24N-R6W) FROM 1882 RR SURVEY BY SURVEYOR BONNEL (ON FILE AT REG DEEDS) AND 1909 NBT (PINE ROOT-STILL EVIDENT-ALSO PREVIOUSLY FD & NOTED BY L.S., BOB MITCHELL IN 1984). NOTE; 1909 NBT IS FROM CO SURVEYOR BEUTHIEN BOOK, T24N-R6W, SE COR OF SEC 35 (6) PG 64 (AT MISS CO RD COMM.)

K-2
REESTABLISHED E 1/4 COR SEC 2 PROPORTIONATE MEAS TO GLO SUR (RUN-OUT SEC). CTR OLD N-S RR GRADE IS 24' EAST. N'LY EDGE OF CREEK IS 747' ± 15' NORTH (GLO = 27 CH'S = 710', TO NEAREST CHAINS).

7
ESTABLISHED SE COR OF FRL NE 1/4 OF FRL NE 1/4 OF SEC 3 PER STANDARD BLM INSTRUCTIONS (RUN-OUT SEC. SET PROP. MEA TO GLO PLAT). CTR OLD N-S LOGGING TRAIL IS 30' WEST.

C. Description of monument for corner and accessories established to perpetuate locating the position of the corner:

I-1
SET DNR MON & CED POST.

6" & 7" B CHERRY	N75°W	31.1'
6" BALSAM	N25°E	36.8'
6" B CHERRY	S75°E	18.0'
4" B CHERRY	S15°E	36.0'

K-1
DROVE 1" X 48" GALV PIPE W/ ALUM DNR CAP. SET CED POST.

9" TAMARACK	N75°W	30.2'
3" MAPLE	N25°W	8.0'
3" BALSAM	N55°E	32.4'
3" MAPLE	S70°E	8.9'
N-S RR GRADE	EAST	45'±
W PINE ROOT (1909)	N56 1/2°E	30.4'

K-2
DROVE 1" X 48" GALV PIPE W/ALUM DNR CAP; SET CED POST.

11" CEDAR	N35°W	12.3'
7" CEDAR	N30°E	16.3'
8" CEDAR	S50°E	5.2'
8" CEDAR	S45°W	11.6'

7
DROVE 5/8" X 34" REROD W/RLS CAP. SET CED POST W/LOC TAG.

6" MAPLE	N40°W	11.7'
3" BALSAM	N50°E	22.3'
9" MAPLE (CLP2)	DUE E	3.3'
2" BALSAM	S15°W	11.3'
3" BALSAM	S50°W	6.8'

Signed by Carl F. Roser Date 8-13-92

Surveyor's Michigan License No. 12028

STATE OF MICHIGAN
CARL F. ROSER
LAND SURVEYOR
NO. 12028
REGISTERED LAND SURVEYOR

FORM APPROVED BY MICHIGAN STATE BOARD OF LAND SURVEYORS, JAN. 28, 1971
REVISED MAY 14, 1975
REVISED JAN., 1983