LAND CORNER RECORDATION CERTIFICATE

Filing Requirement of Act 74, Mich. P.A. 1970

For corners in

MISSAUKEE
(County)

	Located In:	Corner Code ##
1. Public Land Survey	T 23N R 4W	C-3, C-4
	T ____ R ____	D-3, D-4
	T ____ R ____	
	T ____ R ____	
2. Property Controlling	S ____ T ____ R ____	
in Section	S ____ T ____ R ____	
3. Miscellaneous	S ____ T ____ R ____	
Property in Sec.	S ____ T ____ R ____	

Register of Deeds Stamp & File Number

4. Lot No. _____ , Recorded Plat _____
5. Private Claims _____

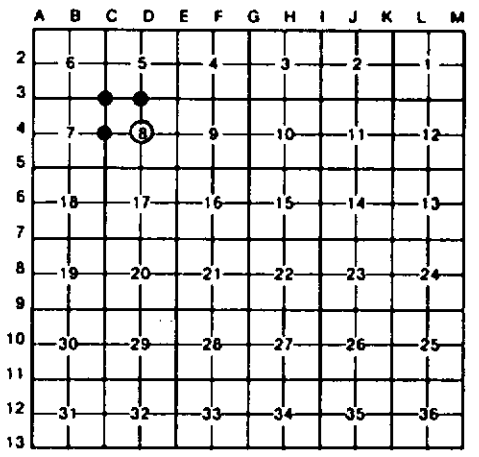

I, CARL F. ROSER, in a field survey on SEPTEMBER 10, 19 92, do hereby certify that under requirements of P.A. 74, Michigan P.A. of 1970, the corner points mentioned in lines 1 and 2 above were in conformance with regulations and rules therefore as required in the current manual of survey instructions of the United States Department of the Interior, Bureau of Land Management or by a decree of a Court of Law and/or that the corner points mentioned in lines 3, 4 and 5 above were in conformance with the rules of the Michigan Board of Land Surveyors or by a Decree of a Court of Law; established, re-established, monumented, re-monumented, recovered, found as expressed below:

NOTE: Not more than 4 corners, all in the same town and range, may be recorded on this certificate.

A. Description of original monument and accessories and/or subsequent restoration:

C-3 C-4 D-3 D-4

STATE OF MICHIGAN
CARL F. ROSER
LAND SURVEYOR
No. 12028
REGISTERED LAND SURVEYOR

B. Description of corner evidence found and/or method applied in restoring or reestablishing corner:

C-3	C-4	D-3	D-4
FD 1/2" REROD AS SET BY L.S. L. CAVANAGH FOR NW COR SEC 8. CTR N-S B.TOP IS 8'E. CTR E-W GRAVEL RD IS 9'± NORTH. OLD ROW FN E IS 37'± NORTH AND NEWER ROW FN E IS 28'± SOUTH.	REESTABLISHED W 1/4 SEC 8 ON SPLIT OF OLD 66' R/W FENCES AND IN LINE W/OLD FN REMAINS TO W ± 1'. CTR 21 1/2' WIDE IRREGULAR BIT RD (LIFT PATCH ON BOTH SIDES) IS 1 1/2'E.	FD 1/2" REROD FOR N 1/4 COR SEC 8. MON IS IN CTR E-W GR RD. MON IS ON SPLIT OF 66' R/W FENCES AND IN LINE W/FN TO N & S.	ESTABLISHED CTR SEC 8 AT INTERSECTION OF 1/4 LINES. CTR E-W FIELD DRIVE IS 11'N. CTR FIELD DRIVE S IS 35' W.

C. Description of monument for corner and accessories established to perpetuate locating the position of the corner:

C-3		C-4		D-3		D-4	
FD 1/2" REROD.		DROVE 5/8" X 34" REROD W/RLS CAP.		FD 1/2' REROD.		DROVE 5/8" X 34" REROD W/RLS CAP & SET CED POST.	
*30" ASH	S55°E 42.76'	4" X 6" TREATED TELE POST	S60°E 35.71'	COR FN POST	NORTH 33.00'	19" B CHERRY(CLP 4). W SIDE STONE PILE	S50°E 15.54'
19" SUG MAPL	S40°E 55.78'	4" X 4" TREATED TELE POST	WEST 34.50'	40" SUG MAPLE	N55°E 112.22'	MAPLE ON SE SIDE STONE PILE	S55°E 34.32'
4" X 4" TREATED POST BY TELE RISER	S50°W 49.48'	2" R PINE	N45°W 56.11'	CED FN POST	S25°E 38.19'	CHISLED "+" ON HIGH POINT 2' X 3' X 1.5' TALL STONE	N80°E 11.3'
SW COR 7' X 8' BLDG.	N55°E 67.8'			38" SUG MAPLE	S80°W 100.65'		

*RLS L. CAVANAGH WIT.

Signed by Carl F. Roser Date 8/13/92

Surveyor's Michigan License No. 12028

FORM APPROVED BY MICHIGAN STATE BOARD OF LAND SURVEYORS, JAN. 28, 1971
REVISED MAY 14, 1975
REVISED JAN., 1983