LAND CORNER RECORDATION CERTIFICATE
Filing Requirement of Act 74, Mich. P.A. 1970

For corners in
MISSAUKEE
(County)

	Located In:	Corner Code ##
1. Public Land Survey	T 23N R 6W	6-5, 6-6
	T ___ R ___	
	T ___ R ___	
	T ___ R ___	
2. Property Controlling	S 15 T ___ R ___	1, 8
in Section	S ___ T ___ R ___	
3. Miscellaneous	S ___ T ___ R ___	
Property in Sec.	S ___ T ___ R ___	

Register of Deeds Stamp & File Number

4. Lot No. _____ , Recorded Plat _____
5. Private Claims _____

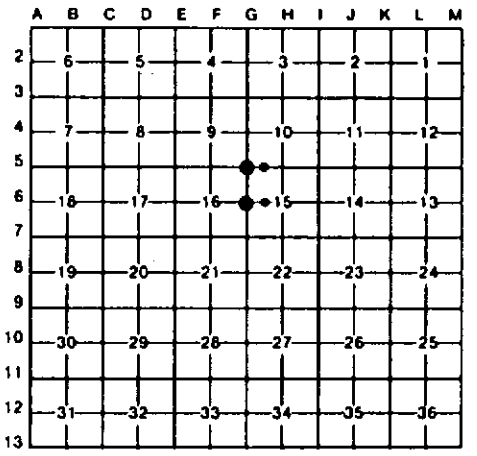

I, CARL F. ROSER, in a field survey on AUGUST 1, 19 90, do hereby certify that under requirements of P.A. 74, Michigan P.A. of 1970, the corner points mentioned in lines 1 and 2 above were in conformance with regulations and rules therefore as required in the current manual of survey instructions of the United States Department of the Interior, Bureau of Land Management or by a decree of a Court of Law and/or that the corner points mentioned in lines 3, 4 and 5 above were in conformance with the rules of the Michigan Board of Land Surveyors or by a Decree of a Court of Law; established, re-established, monumented, re-monumented, recovered, found as expressed below:

NOTE: Not more than 4 corners, all in the same town and range, may be recorded on this certificate.

A. Description of original monument and accessories and/or subsequent restoration:

6-5	6-6	1	8

STATE OF MICHIGAN
CARL F. ROSER
LAND SURVEYOR
No. 12028
REGISTERED LAND SURVEYOR

B. Description of corner evidence found and/or method applied in restoring or reestablishing corner:

6-5
RESTORED SEC COR COMMON TO SEC'S 9-10-15-16 PER DOUBLE PROPORTIONATE MEAS TO 1853 GLO (U.S.) RESURVEY; 1/2 MI W, 2 MI E, 1 MI N AND 1/2 MI S. NO EVIDENCE OF GLO B.T'S. GLO SWP TIES ARE MESSED UP IN THIS AREA. OLD N-S FN REMAINS ARE 87'± W. OLD E-W FN REMAINS ARE 76'± N.

6-6
ACCEPTED FD 2" PIPE FOR 1/4 COR COMMON TO SEC'S 15 & 16. CTR OF E-W GRAVEL RD (WALKER RD) IS 6'± SOUTH. COR IS IN LINE WITH FN REMAINS NORTHERLY AND IN LINE WITH NEWER FN TO SOUTH (FN COR, FN'S S & E, IS 34' SOUTH.)

1
ESTABLISHED WEST 1/8 COR ON SEC LINE COMMON TO SEC'S 10 & 15. MIDWAY & ON LINE BETWEEN 1/4 COR TO E AND SEC COR TO W. CTR OF TRAIL RD S IS 47'± W. CTR E-W WINDING TRAIL RD IS 24' NORTH. OLD E-W FN IS 56'± S. OLD FN W LOOKING TO WEST, IS 54'± N. OLD FN S, LOOKING TO S, IS 59'± W.

8
FD RR RAIL FOR NW COR OF NE 1/4 OF SW 1/4 OF SEC 15. COR IS IN APPROX CTR E-W GRAVEL RD & IN LINE W/FN REMAINS TO S. E-W ROW FN REMAINS IS 33' S. B.WIRE FN N & W IS 27' N & 3'± WEST.

C. Description of monument for corner and accessories established to perpetuate locating the position of the corner:

6-5
SET DNR MON & CED POST.

4" MAPLE	N50°W	36.1'
16" R PINE	N25°W	61.9'
3" W PINE	N65°E	34.0'
9" MAPLE	S40°W	37.4'
14" R PINE	N20°E	67.8'

6-6
FD 2" X 22" LONG PIPE; RAISED W/ 5/8" X 17" REROD W/RLS CAP.

9" R PINE	N45°W	115.7'
11" R PINE	N15°W	81.5'
POWER POLE	N65°E	130.21'
NAILED LOC TAG ON FD CED POST	NORTH	26.0'

1
DROVE 5/8" X 34" REROD W/RLS CAP & SET CED POST W/LOC TAG.

3" R PINE	DUE W	63.7'
17" NORWAY PINE STP	N20°E	46.3'
4" BALSAM	S40°E	36.8'
2" MAPLE (CLP3)	S50°W	29.4'

8
FD NARROW GAUGE RR RAIL, 8" ± LONG.

3" R PINE	N55°E	59.7'
11" R PINE	S45°E	57.6'
24" MAPLE	S20°E	75.7'
6" I BEAM GATE POST	N05°E	27.2'
SET CED POST W/ LOC TAG.	SOUTH	33'

Signed by Carl F. Roser 8/13/92 Date _____

Surveyor's Michigan License No. 12028

FORM APPROVED BY MICHIGAN STATE BOARD OF LAND SURVEYORS, JAN. 26, 1971
REVISED MAY 14, 1975
REVISED JAN., 1983