LAND CORNER RECORDATION CERTIFICATE

Filing Requirement of Act 74, Mich. P.A. 1970

For corners in
MISSAUKEE
(County)

	Located In:	Corner Code ##
1. Public Land Survey	T 23N R 6W	F-9,
	T ___ R ___	
	T ___ R ___	
	T ___ R ___	
2. Property Controlling	S ___ T ___ R ___	
in Section	S ___ T ___ R ___	
3. Miscellaneous	S ___ T ___ R ___	
Property in Sec.	S ___ T ___ R ___	

Register of Deeds Stamp & File Number

4. Lot No. _____ , Recorded Plat _____
5. Private Claims _____

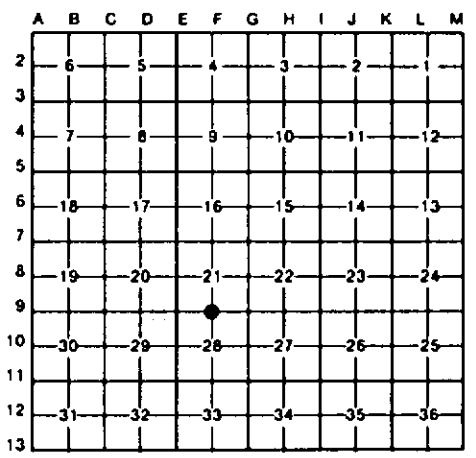

I, CARL F. ROSER, in a field survey on AUGUST 21, 19 90, do hereby certify that under requirements of P.A. 74, Michigan P.A. of 1970, the corner points mentioned in lines 1 and 2 above were in conformance with regulations and rules therefore as required in the current manual of survey instructions of the United States Department of the Interior, Bureau of Land Management or by a decree of a Court of Law and/or that the corner points mentioned in lines 3, 4 and 5 above were in conformance with the rules of the Michigan Board of Land Surveyors or by a Decree of a Court of Law; established, re-established, monumented, re-monumented, recovered, found as expressed below:

NOTE: Not more than 4 corners, all in the same town and range, may be recorded on this certificate.

A. Description of original monument and accessories and/or subsequent restoration:

F-9
RESTORED N 1/4 COR S-28, EQUIDISTANT & ON LINE BETW SEC COR'S TO E & W. COR FALLS IN EDGE OF RIVER. GLO CALLS FOR COR IN RVR; RVR IN THIS AREA HAS CHANGED CONSIDERABLY SINCE GLO SURVEY. BEAVER PONDS AT TIME OF GLO & SINCE HAVE AFFECTED RVR CHANNEL (LOW TAG ALDER AREA). COR POSITION DOES FIT GLO TIE TO WEST OF LEAVE RVR, LEFT BANK, OF 15.38

F-9 CONT.
CHAINS (GLO BOOKED TO NEAREST 1/2 CHAIN) EXACTLY; ONLY PLACE WHERE RVR BANK IS STEEP & HAS NOT CHANGED. ALSO THERE IS A POSSIBLE B.T.(STUMP), BUT NO MARKS WITHIN 7' ± OF OUR S.P. POSITION (GLO CALLS CED 7", NOW 14" STUMP; S03 1/4°E, 17 LINKS; WHICH SHOWS THAT OUR 1/4 COR IS CLOSE TO WHERE THERE WERE CEDARS AT TIME OF GLO SURVEY. WE BRUSHED OUT

F-9 CONT.
LINE WEST ON SEC LINE 15.38 CHAINS TO CHECK GLO TIE TO LEAVE RVR, LEFT BANK.

B. Description of corner evidence found and/or method applied in restoring or reestablishing corner:

C. Description of monument for corner and accessories established to perpetuate locating the position of the corner:

F-9
DROVE 1" X 96" GALV IR PIPE W/ DNR CAP IN RVR (NEAR RT BANK); 14" ABOVE WATER. RVR 25' WD HERE; STREAM FLOWING NORTH HERE; IN BEND (SW) UPSTREAM. WATER 3' DEEP HERE, SAND BOTTOM.

CTR STREAM	WEST	10' ±
14" CED STUMP	S50°E	6.7'
15" TAMARACK	N45°E	105.6'

F-9 CONT.
15" HALF CED STP N35°E 28.4' TO CENTER STP.

F-9 CONT.

STATE OF MICHIGAN
CARL F. ROSER
LAND SURVEYOR
No. 12028
REGISTERED LAND SURVEYOR

Signed by Carl F. Roser Date 8/13/92

Surveyor's Michigan License No. 12028

FORM APPROVED BY MICHIGAN STATE BOARD OF LAND SURVEYORS, JAN. 28, 1971
REVISED MAY 14, 1975
REVISED JAN., 1983