

JAN 27 1999

LIBER 324 PAGE 1276

SECTION

LAND CORNER RECORDATION CERTIFICATE
Filing Requirement of Act 74, Mich. P.A. 1970

#1296

For corners in

Missaukee (County)	Located In:	Corner Code #
1. Public Land Survey	T 23N R 6W	E-1
	T R	
	T R	
	T R	
2. Property Controlling in Section	S T R	
	S T R	
3. Miscellaneous Property in Sec.	S T R	
	S T R	
4. Lot No. _____, Recorded Plat _____		
5. Private Claims _____		

MISSAUKEE COUNTY MICHIGAN

RECORDED DEC 28 1998 1:00 PM

Paulyn Filare
REGISTER

Register of Deeds Stamp & File Number

I, Daniel E. Schripsema, in a field survey on October 1, 19 98 do hereby state that under requirements of P.A. 74, Michigan P.A. of 1970, the corner points mentioned in lines 1 and 2 above were in conformance with regulations and rules therefore as required in the current manual of survey instructions of the United States Department of the Interior, Bureau of Land Management or by a decree of a Court of Law and /or that the corner points mentioned in lines 3, 4 and 5 above were in conformance with the rules of the Michigan Board of Land Surveyors or by a Decree of a Court of Law; established, re-established, monumented, recovered, found as expressed below:

NOTE: Not more than 2 corners, all in the same town and range, may be recorded on this certificate

	A	B	C	D	E	F	G	H	I	J	K	L	M
1					●								
2	6			5		4		3		2		1	
3													
4	7			8		9		10		11		12	
5													
6	18			17		16		15		14		13	
7													
8	19			20		21		22		23		24	
9													
10	30			29		28		27		26		25	
11													
12	31			32		33		34		35		36	
13													

A. Description of original monument and accessories and/or subsequent restoration:

- E-1) 1838 John Brink GLO survey, do 11" diameter iron corner Sections 4 & 5
- 1895 Richardson Pg.68, Cedar stake 3', 3x3 sq. + wagon skein on N. side below surface, Stone on top
- 1992 Carl Roser survey; Fd old wagon skein for NW Cor section 4 as called for in old survey notes by Richardson.
- 1895, E.A. Beuthien 1918 notes call for cor in ctr of grade & 16' N. of E-W fence. We found old fn. remains west approx. 15' South. Cor is in approx. intersection N-S gravel rd & E-W trail road.
- 1992 L.C.R.C. L.1, pg. 861, Fd. Wagon skein, 4" W. Pine N55E 40.42, 13" Maple Clump N60E 49.88, 12" R. Pine S40E 59.00, 10" R. Pine S65W 84.79

B. Description of corner evidence found and/or method applied in restoring or reestablishing corner:

- E-1) Section Corner common to Sections 32 and 33, T24N, R6W and Sections 4 and 5, T23N, R6W. Found Wagon Skein in approx. intersection

This corner is accepted as a careful and faithful perpetuation of the position of the original corner.

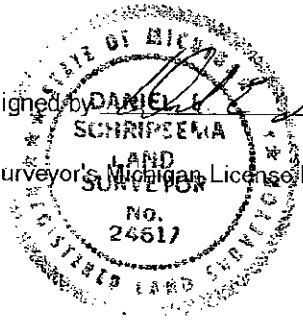
C. Description of monument for corner and accessories established to perpetuate locating the position of the corner:

- E-1) Set 1/2" Iron & Missaukee County Monument

- Fd Wagon Skein
- 7" W. Pine N55W 40.40
- 13" Maple Clump N60E 49.88
- 12" R. Pine S40E 59.00
- 10" R. Pine S65W 84.79

Peer Group Reviewed and Approved

Date: 12-22-98
[Signature]
D. Geers, Missaukee Co. Representative

Signed by Daniel E. Schripsema

 Surveyor's Michigan License No. 24617

Date 12-22-98