

LAND CORNER RECORDATION CERTIFICATE
Filing Requirement of Act 74, Mich. P.A. 1970

For corners in

| | | |
|---------------------------------------|--------------------------|---------------|
| <u>Missaukee County</u> (County) | Located In: | Corner Code # |
| 1. Public Land Survey | T <u>23N</u> R <u>6W</u> | <u>M-3</u> |
| | T ___ R ___ | _____ |
| | T ___ R ___ | _____ |
| | T ___ R ___ | _____ |
| 2. Property Controlling in Section | S ___ T ___ R ___ | _____ |
| | S ___ T ___ R ___ | _____ |
| 3. Miscellaneous Property in Sec. | S ___ T ___ R ___ | _____ |
| | S ___ T ___ R ___ | _____ |
| 4. Lot No. _____, Recorded Plat _____ | | |
| 5. Private Claims _____ | | |

1213
LIBER 315 PAGE 1115
MISSAUKEE COUNTY MICHIGAN
 RECORDER DEC 29 1997 125 P.M.
Carolyn Flare
 Register of Deeds Stamp & Fee
 Number

| | | | | | | | | | | | | | |
|----|----|---|----|---|----|---|----|---|----|---|----|---|---|
| | A | B | C | D | E | F | G | H | I | J | K | L | M |
| 1 | | | | | | | | | | | | | |
| 2 | 6 | | 5 | | 4 | | 3 | | 2 | | 1 | | |
| 3 | | | | | | | | | | | | | |
| 4 | 7 | | 8 | | 9 | | 10 | | 11 | | 12 | | |
| 5 | | | | | | | | | | | | | |
| 6 | 18 | | 17 | | 16 | | 15 | | 14 | | 13 | | |
| 7 | | | | | | | | | | | | | |
| 8 | 19 | | 20 | | 21 | | 22 | | 23 | | 24 | | |
| 9 | | | | | | | | | | | | | |
| 10 | 30 | | 29 | | 28 | | 27 | | 26 | | 25 | | |
| 11 | | | | | | | | | | | | | |
| 12 | 31 | | 32 | | 33 | | 34 | | 35 | | 36 | | |
| 13 | | | | | | | | | | | | | |

I, Daniel E. Schripsema, in a field survey on October 1, 1997 do hereby state that under requirements of P.A. 74, Michigan P.A. of 1970, the corner points mentioned in lines 1 and 2 above were in conformance with regulations and rules therefore as required in the current manual of survey instructions of the United States Department of the Interior, Bureau of Land Management or by a decree of a Court of Law and /or that the corner points mentioned in lines 3, 4 and 5 above were in conformance with the rules of the Michigan Board of Land Surveyors or by a Decree of a Court of Law; established, re-established, monumented, recovered, found as expressed below:

NOTE: Not more than 2 corners, all in the same town and range, may be recorded on this certificate

A. Description of original monument and accessories and/or subsequent restoration:

- M-3) 1839 GLO survey set post corner sections 1, 12; Tamarack 11 S42W 18, do 10 N16W 10 1985 Robert F. Mitchell LCRC, #696; Set 1/2" rerod w/ cap S71W P. Pole 34.85', S76E 4" Poplar 45.02', S47E 16" Poplar 68.16'
- 1992 Carl F. Roser LCRC, #858; Fd. 1/2" rerod w/ cap P. Pole S62W 34.85', 17" Poplar S45E 68.22', E 1/4 Sec. 1-5/8" rerod w/ cap N01-07-19W 2649.76' E 1/4 Sec. 12 S00-01-07E 2649.41', Set Cedar Post w/ tag West 33'

B. Description of corner evidence found and/or method applied in restoring or reestablishing corner:

- M-3) Corner common to Sections 1 & 12, T23N, R6W and Sections 6 & 7, T23N, R5W. Found 1/2" rerod and cap of record. Corner falls 1' east of N&S road centerline
- This corner is accepted as a careful and faithful reestablishment of the position of the original corner.


C. Description of monument for corner and accessories established to perpetuate locating the position of the corner:

- M-3) Set Missaukee County Monument on existing corner.
- | | | | |
|------|--------|------------------|---|
| S62W | 34.87' | Power pole | * |
| N87W | 32.84' | DNR cedar post | |
| S46E | 68.08' | 20" poplar | |
| N30E | 61.67' | phone riser post | |

Peer Group Reviewed and Approved
 Date: 12-18-97
J. Dean Geers
 J. Dean Geers, Missaukee Co. Representative

Signed by *Daniel E. Schripsema* Date 12-2-97

Surveyor's Michigan License No. 24617

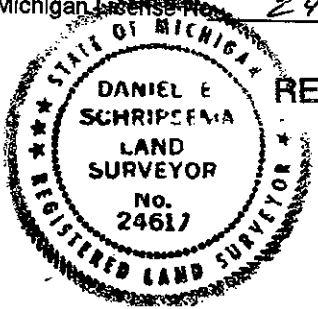

SURVEY & REMONUMENTATION

JAN 16 1998

SECTION

FORM APPROVED BY MICHIGAN STATE BOARD OF PROFESSIONAL SURVEYORS, JAN. 28, 1971
 REVISED MAY 14, 1975
 REVISED JAN., 1983
 REVISED OCT., 1985