

LAND CORNER RECORDATION CERTIFICATE
Filing Requirement of Act 74, Mich. P.A. 1970

For corners in

<u>Missaukee</u> (County)	Located In:	Corner Code #
1. Public Land Survey	T 23N R 6W	M-7
	T R	
	T R	
	T R	
2. Property Controlling in Section	S T R	
	S T R	
3. Miscellaneous Property in Sec.	S T R	
	S T R	
4. Lot No. _____, Recorded Plat _____		
5. Private Claims _____		

1205
LIBER 315 PAGE 1107
MISSAUKEE COUNTY MICHIGAN
RECORDED DEC 29 1997 1:25 P.M.
Paulyn Flare
REGISTER
Register of Deeds Stamp & File Number

	A	B	C	D	E	F	G	H	I	J	K	L	M
1													
2	6		5		4		3		2		1		
3													
4	7		8		9		10		11		12		
5													
6	18		17		16		15		14		13		
7													
8	19		20		21		22		23		24		
9													
10	30		29		28		27		26		25		
11													
12	31		32		33		34		35		36		
13													

I, Daniel E. Schripsema, in a field survey on October 1, 1997 do hereby state that under requirements of P.A. 74, Michigan P.A. of 1970, the corner points mentioned in lines 1 and 2 above were in conformance with regulations and rules therefore as required in the current manual of survey instructions of the United States Department of the Interior, Bureau of Land Management or by a decree of a Court of Law and for that the corner points mentioned in lines 3, 4 and 5 above were in conformance with the rules of the Michigan Board of Land Surveyors or by a Decree of a Court of Law; established, re-established, monumented, recovered, found as expressed below:

NOTE: Not more than 2 corners, all in the same town and range, may be recorded on this certificate

A. Description of original monument and accessories and/or subsequent restoration:

M-7) 1839 GLO survey set post sections 13 & 24; Hemlock 10 S61W 10, White Pine 9 N64W 21 1913 Beuthien survey, FB #24, pg. 57, county surveyor notes; WPS 48 N40 1/2W 190

B. Description of corner evidence found and/or method applied in restoring or reestablishing corner:

M-7) Corner common to Sections 13 & 24, T23N, R6W and Sections 18 & 19, T23N, R5W. Reset corner from WPS (1913 record) 48" N40 1/2W 190 links (125.4'). Corner falls at west edge of trail road, 32.7'E & 13.7' S of fence N, S, & W, and 9.8' E and 12.5'N of found 1 1/2" pipe which is 13.5'W of trail centerline.

This corner is accepted as a careful and faithful perpetuation of the position of the original corner.


C. Description of monument for corner and accessories established to perpetuate locating the position of the corner:

- M-7) Set Missaukee County Monument on 1/2" iron
- S42E 59.80' 20" Scotch Pine
- S20W 28.50' 10" Poplar
- S37W 15.56' 1 1/2" Pipe
- S74W 76.98' 10" Apple clump
- N63W 33.02' 4" Cherry

Peer Group Reviewed and Approved
 Date: 12-18-97
J. Dean Geers
 J. Dean Geers, Missaukee Co. Representative

Signed by Daniel E. Schripsema Date 12-02-97

Surveyor's Michigan License No. 24617

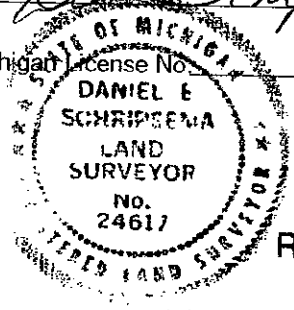

SURVEY & REMONUMENTATION

JAN 16 1998

SECTION