

LAND CORNER RECORDATION CERTIFICATE
Filing Requirement of Act 74, Mich. P.A. 1970

For corners in

Missaukee County
 (County) Located In: _____ Corner Code # _____

1. Public Land Survey T 23N R 6W M-8
 T _____ R _____
 T _____ R _____
 T _____ R _____

2. Property Controlling in Section S _____ T _____ R _____
 S _____ T _____ R _____

3. Miscellaneous Property in Sec. S _____ T _____ R _____
 S _____ T _____ R _____

1216

LIBER 315 PAGE 1119
 MISSAUKEE COUNTY MICHIGAN
 RECORDED DEC 29 1997 1:25 P.M.
Carolyn Flare
 REGISTER
 Register of Deeds Stamp & File Number

4. Lot No. _____, Recorded Plat _____
 5. Private Claims _____

I, Daniel E. Schripsema, in a field survey on October 1, 1997 do hereby state that under requirements of P.A. 74, Michigan P.A. of 1970, the corner points mentioned in lines 1 and 2 above were in conformance with regulations and rules therefore as required in the current manual of survey instructions of the United States Department of the Interior, Bureau of Land Management or by a decree of a Court of Law and /or that the corner points mentioned in lines 3, 4 and 5 above were in conformance with the rules of the Michigan Board of Land Surveyors or by a Decree of a Court of Law, established, re-established, monumented, recovered, found as expressed below.

NOTE: Not more than 2 corners, all in the same town and range, may be recorded on this certificate

	A	B	C	D	E	F	G	H	I	J	K	L	M
1													
2	6			5		4		3		2		1	
3													
4	7			8		9		10		11		12	
5													
6	18			17		16		15		14		13	
7													
8	19			20		21		22		23		24	
9													
10	30			29		28		27		26		25	
11													
12	31			32		33		34		35		36	
13													

A. Description of original monument and accessories and/or subsequent restoration:

M-8) 1839 GLO survey set quarter post section 24; Beech 8 S67W 40, do 9 N53W 42
 1913 Beuthien survey, FB #24, pg. 57, county surveyor notes; Elm 10 S50W 22, CF Post 7 N82W 38

B. Description of corner evidence found and/or method applied in restoring or reestablishing corner:

M-8) Corner common to Section 24, T23N, R6W and Section 19, T23N, R5W. Found 1 1/2" well point in centerline of N&S gravel road, 10' south of old RR grade to east, and 40' North of field line west.

This corner is accepted as a careful and faithful perpetuation of the position of the original corner.

C. Description of monument for corner and accessories established to perpetuate locating the position of the corner:


M-8) Set Missaukee County Monument on 1/2" rerod in 1 1/2" pipe

S35E 37.61' 8" ash
 S62E 32.02' 10" cherry
 N68E 42.71' 6" x 6" n. gate post
 S32W 35.58' 10" elm in clump

Peer Group Reviewed and Approved
 Date: 12-18-97
J. Dean Beers
 J. Dean Beers, Missaukee Co. Representative

Signed by Daniel E. Schripsema
 Surveyor's Michigan License No. 24617

Date 12-2-97

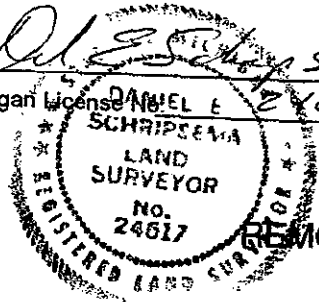

SURVEY & MONUMENTATION

JAN 16 1998

SECTION