

LAND CORNER RECORDATION CERTIFICATE
Filing Requirement of Act 74, Mich. P.A. 1970

For corners in

Missaukee County (County) Located In: _____ Corner Code # _____

1. Public Land Survey T 23N R 6W M-11
 T _____ R _____
 T _____ R _____
 T _____ R _____

2. Property Controlling in Section S _____ T _____ R _____
 S _____ T _____ R _____

3. Miscellaneous Property in Sec. S _____ T _____ R _____
 S _____ T _____ R _____

#1219
 LIBER 315 PAGE 1127
 MISSAUKEE COUNTY MICHIGAN
 RECORDED DEC 29 1997 125 P.M.
Carolyn Klare
 REGISTER
 Register of Deeds Stamp & File Number

4. Lot No. _____, Recorded Plat _____
 5. Private Claims _____

I, Daniel E. Schripsema, in a field survey on October 1, 1997 do hereby state that under requirements of P.A. 74, Michigan P.A. of 1970, the corner points mentioned in lines 1 and 2 above were in conformance with regulations and rules therefore as required in the current manual of survey instructions of the United States Department of the Interior, Bureau of Land Management or by a decree of a Court of Law and/or that the corner points mentioned in lines 3, 4 and 5 above were in conformance with the rules of the Michigan Board of Land Surveyors or by a Decree of a Court of Law; established, re-established, monumented, recovered, found as expressed below:

	A	B	C	D	E	F	G	H	I	J	K	L	M
1													
2	6		5		4		3		2		1		
3													
4	7		8		9		10		11		12		
5													
6	18		17		16		15		14		13		
7													
8	19		20		21		22		23		24		
9													
10	30		29		28		27		26		25		
11													
12	31		32		33		34		35		36		
13													

NOTE: Not more than 2 corners, all in the same town and range, may be recorded on this certificate

A. Description of original monument and accessories and/or subsequent restoration:

M-11) 1839 GLO survey set post corner sections 25, 36; Tamarack 14 S52W 19, do 10' N45W 42
 1978 Frederick H. Thomson survey, liber S-1, pg. 442; Fd. 1" iron pipe
 S40E 7.6' 6" Cedar, S85W 9.0' 4" Ash, N56E 13.2' 3" Spruce, S20W 8.8' 5" Cedar

B. Description of corner evidence found and/or method applied in restoring or reestablishing corner:

M-11) Corner common to Sections 25 & 36, T23N, R6W and Sections 30 & 31, T23N, R5W. Found 1" iron pipe of record.
 This corner is accepted as a careful and faithful perpetuation of the position of the original corner


C. Description of monument for corner and accessories established to perpetuate locating the position of the corner:

M-11) Set Missaukee County Monument on existing iron
 S40E 7.6' 6" cedar
 S85W 9.0' 4" ash
 N56E 13.2' 3" spruce
 S20W 8.8" 5" cedar

Peer Group Reviewed and Approved
 Date: 12-18-97
J. Dean Geers
 J. Dean Geers, Missaukee Co. Representative

Signed by Daniel E. Schripsema
 Surveyor's Michigan License No. 24617

Date 12-2-97

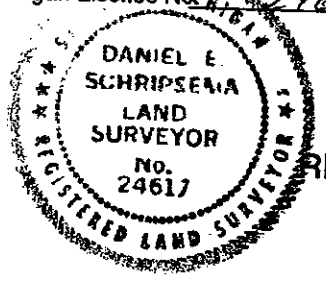

SURVEY & REMONUMENTATION

JAN 16 1998

SECTION